



# NAN09 NANDOS PENRITH | s96 APPLICATION | 06.10.17

SHOP 54/55 | LEVEL 1, 585 HIGH ST, PENRITH NSW 2750





DOCUMENT REGISTER							
DAY	16	19	25	26	28	18	6
MONTH	6	7	7	7	7	8	10
YEAR	16	16	16	16	16	17	17
DRG No.	DRG TITLE	SCALE					
	Cover Page	NTS	/	/	/	/	/
A-00	Location & Site Plan	NTS	C	C	C	C	D D
A-01	External Layout Plan	1:100	M	N	O	P	Q R S
A-02	External RCP	1:100	C	D	E	F	G H H
E-01	Shopfront Elevation	1:75	D	E	F	G	H I J
DISTRIBUTION	CONTACT	No. Copies					
Council	tbc						
I=Information T=Tender A=Approval C=Construction			<b>ISSUE TYPE</b>				
P=Post X=Express Post E=Email H=Hand F=Fax			A A A A A A A				
			<b>ISSUE METHOD</b>				
			P E E E E E E				

**NOTE:**

**THIS S96 APPLICATION IS FOR AN ADDITIONAL FASCIA SIGN ONLY TO THE WESTFIELD RILEY STREET UPGRADE & TO ALIGN WITH THE ADJACENT RESTAURANTS**


**NANDOS PENRITH**  
SHOP 54/55 - LEVEL 1, 585 HIGH ST, PENRITH NSW 2750

**NANDOS PENRITH**  
SHOP 54/55 - LEVEL 1, 585 HIGH ST, PENRITH NSW 2750

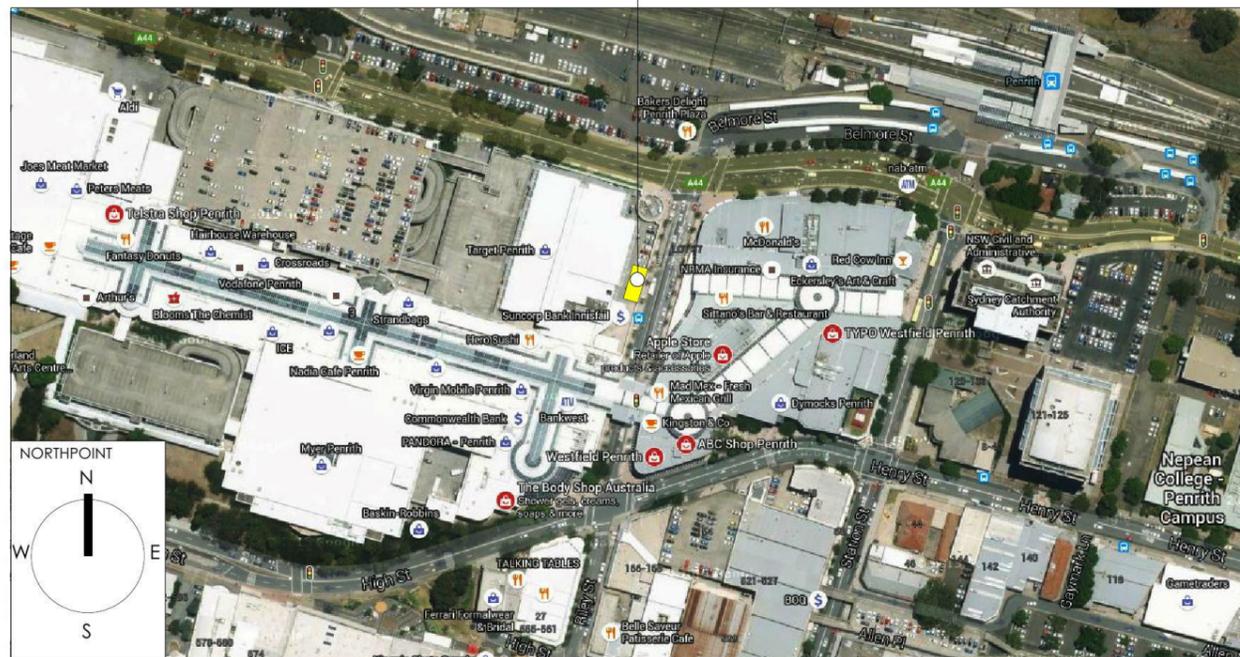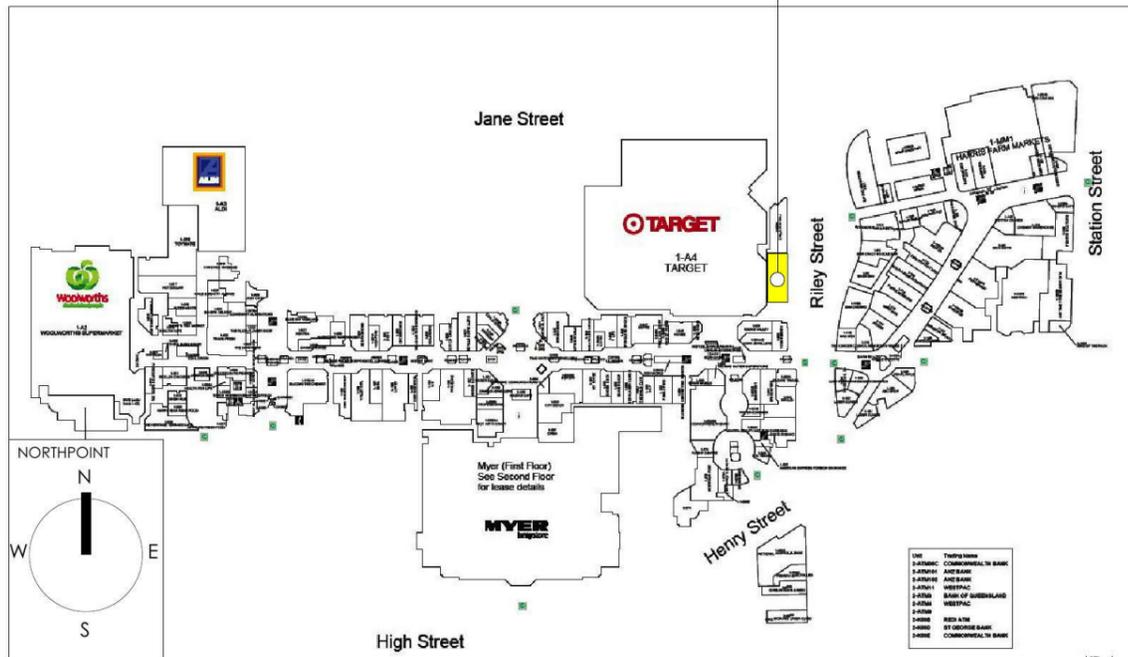

01 location plan  
scale NTS

02 site plan  
scale NTS

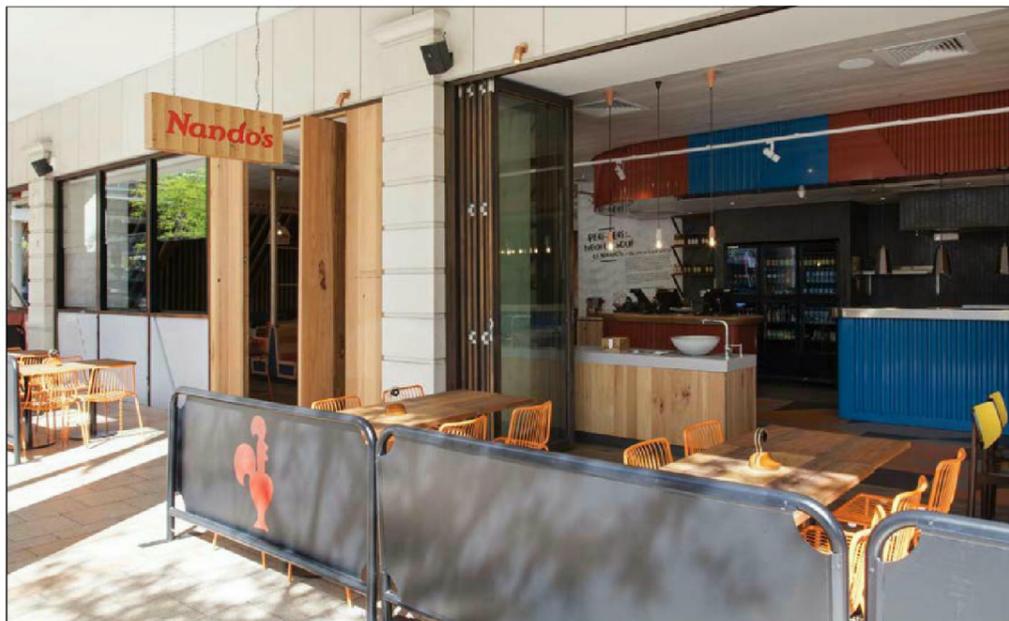

02 existing shopfront  
scale NTS

02 existing shopfront  
scale NTS

**NOTE:**  
**THIS S96 APPLICATION IS FOR AN ADDITIONAL FASCIA SIGN ONLY TO THE WESTFIELD RILEY STREET UPGRADE & TO ALIGN WITH THE ADJACENT RESTAURANTS**

**FOR s96 APPLICATION**

**NOTE**  
CONTRACTOR TO CHECK ALL DIMENSIONS ON SITE PRIOR TO COMMENCING CONSTRUCTION  
DO NOT SCALE FROM THIS DRAWING USE GIVEN DIMENSIONS  
ALL BUILDING WORK TO COMPLY WITH AUSTRALIAN STANDARDS & THE BUILDING CODE OF AUSTRALIA  
ALL WORK TO COMPLY WITH AS4674: DESIGN, CONSTRUCTION & FITOUT OF FOOD PREMISES  
© COPYRIGHT 2017 - ALL DESIGNS & ARRANGEMENTS REPRESENTED BY THESE DRAWINGS ARE THE PROPERTY OF DESIGN CLARITY PTY LTD /& DESIGN CLARITY LTD, & HAVE BEEN CREATED FOR USE WITH THE SPECIFIED PROJECT & SPECIFIED SITE ONLY. THE USE OR COPYING OF THESE DOCUMENTS WITHOUT THE EXPRESS PERMISSION OF THE AUTHOR IS DEEMED TO BE A BREACH OF COPYRIGHT.

REVISION	DATE	DESCRIPTION
A	11.01.16	ISSUE FOR TENDER
B	10.06.16	CONSTRUCTION ISSUE
C	15.06.16	REVISED CONSTRUCTION ISSUE
D	17.08.17	REVISED AS PER CLIENT FEEDBACK

**des clarity**  
info@designclarity.net  
www.designclarity.net

**sydney**  
studio 204, 61 marlborough st, surry hills, nsw 2010  
p +61 (0)2 9319 0933  
design clarity pty ltd | abn 78 094 440 883

**melbourne**  
suite 2, 16 northumberland st,  
south melbourne, vic 3205  
p +61 (0)3 9077 6022  
design clarity pty ltd | abn 78 094 440 883

**london**  
suite 5, islington house, 313/314 upper st, n1 2xq  
p +44 (0)20 7403 6132  
design clarity ltd | reg in london no. 5254606

DRAWING TITLE  
**LOCATION & SITE PLAN**

PROJECT  
**NANDOS PENRITH**


SHOP 54/55  
LEVEL 1, 585 HIGH ST,  
PENRITH NSW 2750

scale NTS	START DATE 27.07.15
DRAWN BY SN/LL	REVISION <b>D</b>
CHECKED BY KH	CHECK DATE 17.08.16

PROJECT No. NAN09	DRAWING No. A-00
----------------------	---------------------

**NOTE:**

**THIS S96 APPLICATION IS FOR AN ADDITIONAL FASCIA SIGN ONLY TO THE WESTFIELD RILEY STREET UPGRADE & TO ALIGN WITH THE ADJACENT RESTAURANTS**

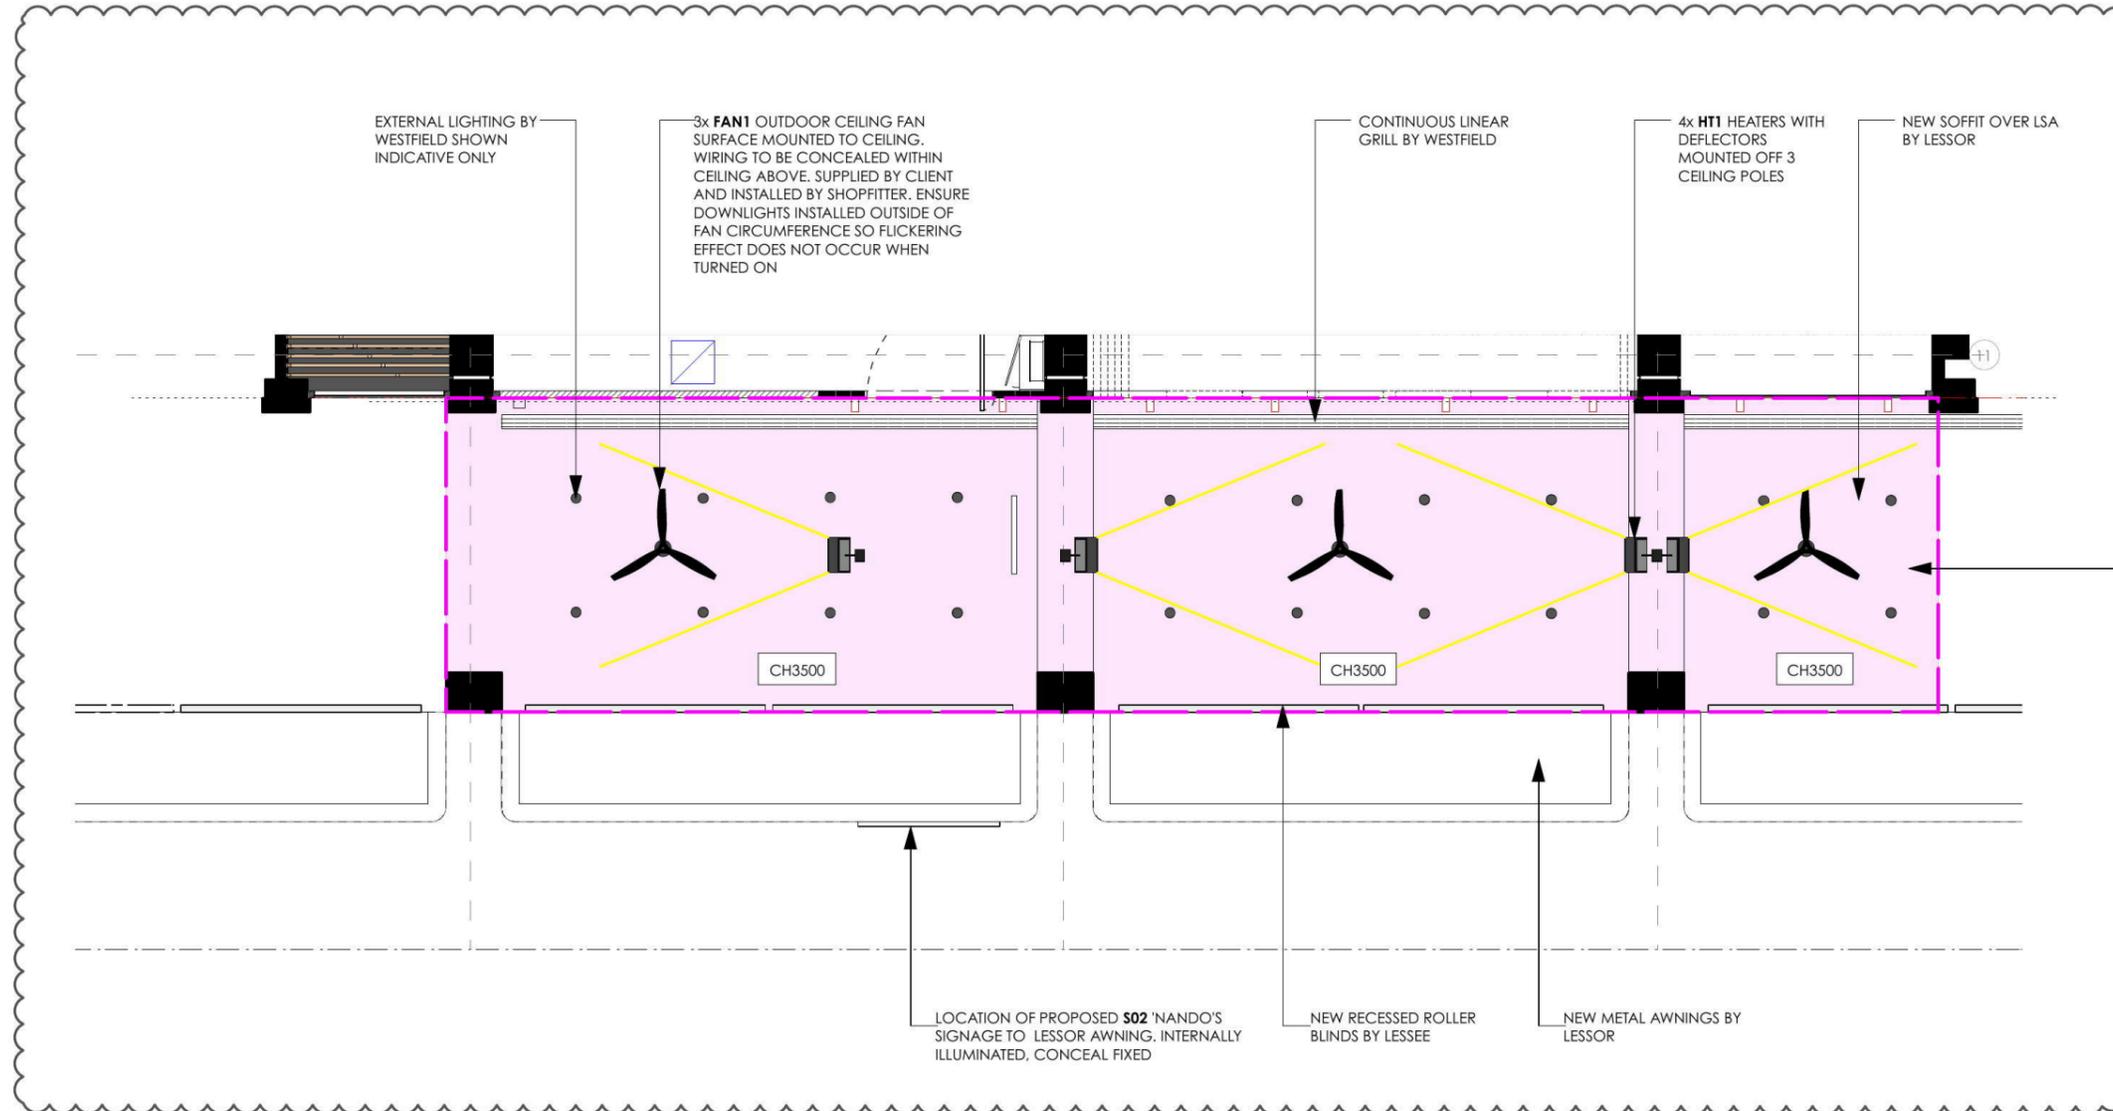

**NOTE:**

EXTERNAL AUDIO SUPPLIED BY CLIENT AND INSTALLED BY SHOPFITTER. LOCATION AND QUANTITIES TBC  
 EXTERNAL FANS TO BE SUPPLIED AND INSTALLED BY SHOPFITTER  
 EXTERNAL HEATING SUPPLIED BY CLIENT AND INSTALLED BY WESTFIELD

EXTENT OF EXTERNAL SEATING ZONE SHOWN DASHED & SHADED IN PURPLE

**NOTE**  
 CONTRACTOR TO CHECK ALL DIMENSIONS ON SITE PRIOR TO COMMENCING CONSTRUCTION  
 DO NOT SCALE FROM THIS DRAWING USE GIVEN DIMENSIONS  
 ALL BUILDING WORK TO COMPLY WITH AUSTRALIAN STANDARDS & THE BUILDING CODE OF AUSTRALIA  
 ALL WOKT TO COMPLY WITH AS4674: DESIGN, CONSTRUCTION & FITOUT OF FOOD PREMISES  
 © COPYRIGHT 2017 - ALL DESIGNS & ARRANGEMENTS REPRESENTED BY THESE DRAWINGS ARE THE PROPERTY OF DESIGN CLARITY PTY LTD /& DESIGN CLARITY LTD, & HAVE BEEN CREATED FOR USE WITH THE SPECIFIED PROJECT & SPECIFIED SITE ONLY. THE USE OR COPYING OF THESE DOCUMENTS WITHOUT THE EXPRESS PERMISSION OF THE AUTHOR IS DEEMED TO BE A BREACH OF COPYRIGHT.

REVISION	DATE	DESCRIPTION
A	21.03.16	ISSUE FOR TENDER
B	27.04.16	RE-ISSUE FOR TENDER
C	10.06.16	CONSTRUCTION ISSUE
D	15.06.16	REVISED CONSTRUCTION ISSUE
E	22.06.16	REVISED CONSTRUCTION ISSUE
F	29.06.16	REVISED CONSTRUCTION ISSUE
G	14.09.16	AS BUILT ISSUE
H	18.08.17	REVISED AS PER CLIENT FEEDBACK

**design clarity**  
 info@designclarity.net  
 www.designclarity.net

**sydney**  
 studio 204, 61 marlborough st, surry hills, nsw 2010  
 p +61 (0)2 9319 0933  
 design clarity pty ltd | abn 78 094 440 883

**melbourne**  
 suite 2, 16 northumberland st,  
 south melbourne, vic 3205  
 p +61 (0)3 9077 6022  
 design clarity pty ltd | abn 78 094 440 883

**london**  
 suite 5, islington house, 313/314 upper st, n1 2xq  
 p +44 (0)20 7403 6132  
 design clarity ltd | reg in london no. 5254606

DRAWING TITLE  
 EXTERNAL RCP

PROJECT  
 NANDOS PENRITH

SHOP 54/55  
 LEVEL 1, 585 HIGH ST,  
 PENRITH NSW 2750

scale  
 1:100 @ A3

DRAWN BY  
 BMS/LL

CHECKED BY  
 DL/KH/  
 SN

REVISION  
**H**

CHECK DATE  
 18.08.17

START DATE  
 27.07.15


PROJECT No.  
 NAN09

DRAWING No.  
 A-02

FOR s96 APPLICATION

**NOTE:**

**THIS S96 APPLICATION IS FOR AN ADDITIONAL FASCIA SIGN ONLY TO THE WESTFIELD RILEY STREET UPGRADE & TO ALIGN WITH THE ADJACENT RESTAURANTS**

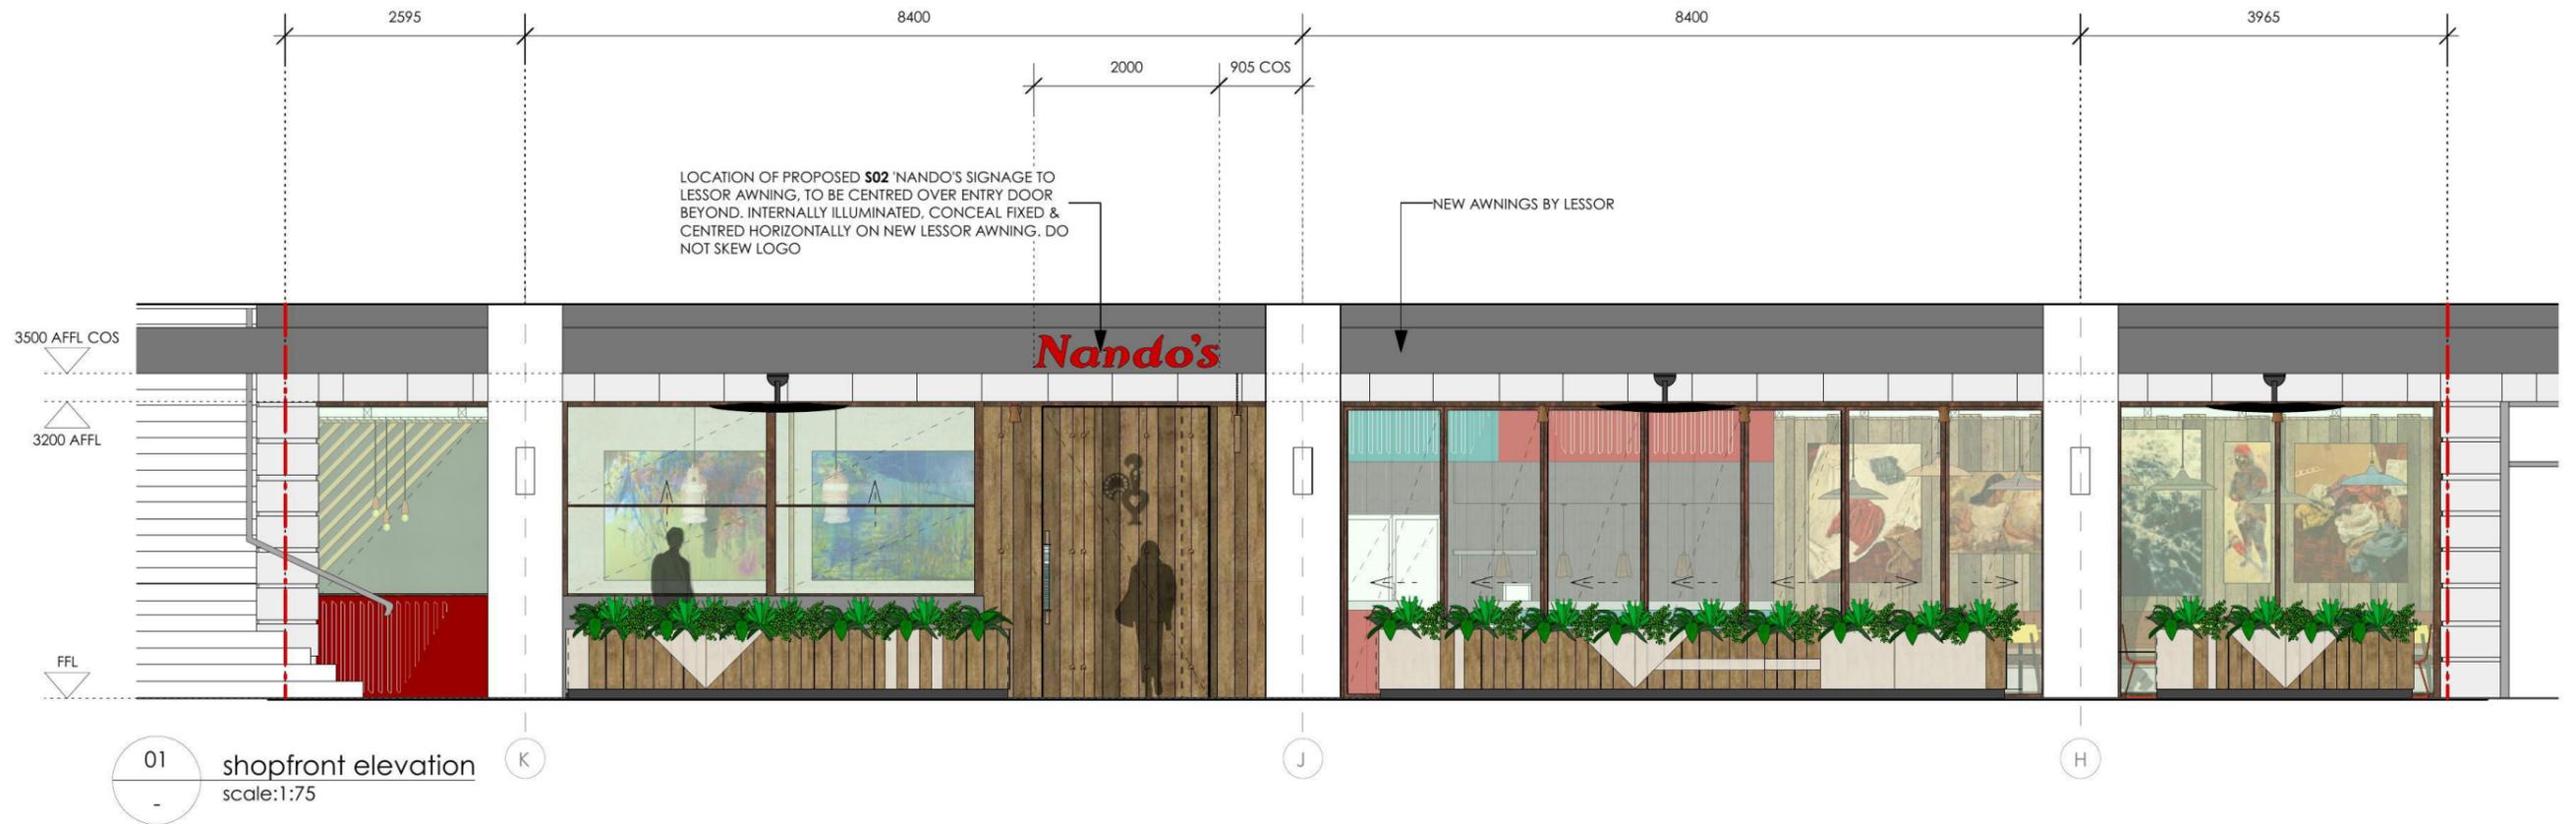

**NOTE**  
 CONTRACTOR TO CHECK ALL DIMENSIONS ON SITE PRIOR TO COMMENCING CONSTRUCTION  
 DO NOT SCALE FROM THIS DRAWING USE GIVEN DIMENSIONS  
 ALL BUILDING WORK TO COMPLY WITH AUSTRALIAN STANDARDS & THE BUILDING CODE OF AUSTRALIA  
 ALL WOKT TO COMPLY WITH AS4674: DESIGN, CONSTRUCTION & FITOUT OF FOOD PREMISES  
 © COPYRIGHT 2017 - ALL DESIGNS & ARRANGEMENTS REPRESENTED BY THESE DRAWINGS ARE THE  
 PROPERTY OF DESIGN CLARITY PTY LTD /& DESIGN CLARITY LTD, & HAVE BEEN CREATED FOR USE WITH  
 THE SPECIFIED PROJECT & SPECIFIED SITE ONLY. THE USE OR COPYING OF THESE DOCUMENTS WITHOUT  
 THE EXPRESS PERMISSION OF THE AUTHOR IS DEEMED TO BE A BREACH OF COPYRIGHT.

REVISION	DATE	DESCRIPTION
B	25.08.15	UPDATED SHOPFRONT ELEVATION AS PER CLIENT FEEDBACK
C	11.01.16	ISSUE FOR TENDER
D	21.03.16	RE-ISSUE FOR TENDER
E	27.04.16	RE-ISSUE FOR TENDER
F	10.06.16	CONSTRUCTION ISSUE
G	15.06.16	REVISED CONSTRUCTION ISSUE
H	14.09.16	AS BUILT ISSUE
I	17.08.17	REVISED SHOPFRONT AS PER CLIENT FEEDBACK
J	06.10.17	REVISED SHOPFRONT AS PER CLIENT FEEDBACK

**design clarity**  
 info@designclarity.net  
 www.designclarity.net

**sydney**  
 studio 204, 61 marlborough st, surry hills, nsw 2010  
 p +61 (0)2 9319 0933  
 design clarity pty ltd | abn 78 094 440 883

**melbourne**  
 suite 2, 16 northumberland st,  
 south melbourne, vic 3205  
 p +61 (0)3 9077 6022  
 design clarity pty ltd | abn 78 094 440 883

**london**  
 suite 5, islington house, 313/314 upper st, n1 2xq  
 p +44 (0)20 7403 6132  
 design clarity ltd | reg in london no. 5254606

DRAWING TITLE  
 SHOPFRONT ELEVATION

PROJECT  
 NANDOS PENRITH

SHOP 54/55  
 LEVEL 1, 585 HIGH ST,  
 PENRITH NSW 2750



scale  
 1:75 @ A3

DRAWN BY  
 BMS/LL/  
 IW/SM

REVISION  
**J**

CHECKED BY  
 DL/KH/  
 SN

CHECK DATE  
 06.10.17

START DATE  
 27.07.15

PROJECT No.  
 NAN09

DRAWING No.  
 E-**01**

FOR s96 APPLICATION