

Appendix B


Site Plans

Appendix B Site Plans

WORTH RECYCLING

42-46 CHARLES ST. ST. MARYS NSW

AS BUILT DRAWINGS

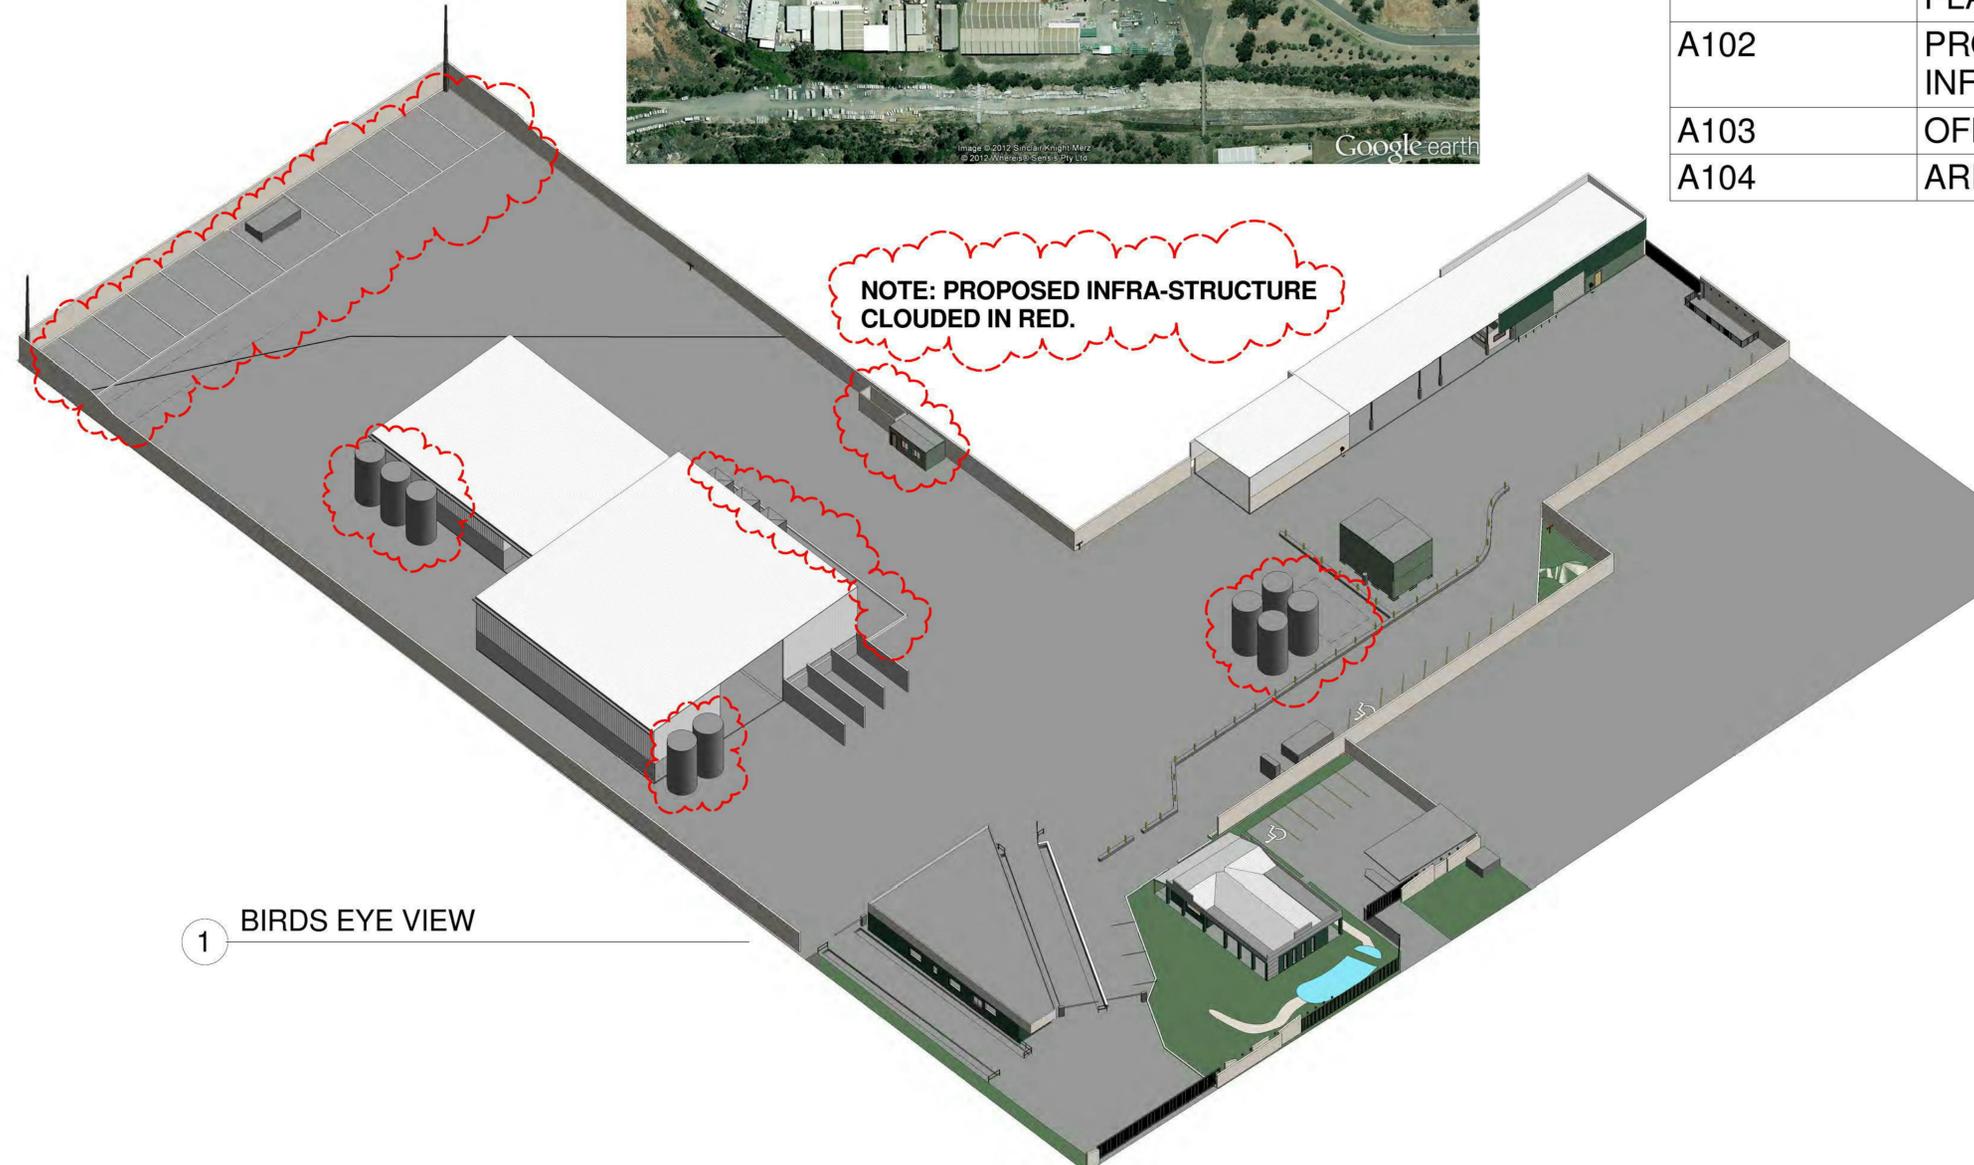

1 BIRDS EYE VIEW

Sheet List	
Sheet Number	Sheet Name
A100	TITLE SHEET & 3D VIEW
A101	EXISTING AS BUILT SITE PLAN
A102	PROPOSED INFRA-STRUCTURE
A103	OFFICE A & B
A104	AREA 1, 2, 3, 4 & 5, 6, 7

COPYRIGHT ACT: THE DESIGNS CONTAINED HEREIN REMAIN THE PROPERTY OF C.K. ARCHITECTS PTY LTD. PERMISSION MUST BE SOUGHT FOR USE OF DESIGN OR REPRODUCTION.

GENERAL NOTES

1. USE WRITTEN DIMENSIONS ONLY. THIS DRAWING SHALL NOT BE SCALED.
2. THIS DRAWING SHALL BE READ IN CONJUNCTION WITH THE SPECIFICATION.
3. ALL DIMENSIONS, AS SHOWN ON DRAWINGS, SHALL BE CHECKED AND VERIFIED BY THE BUILDER BEFORE ANY CONSTRUCTION OR FABRICATION TO BE COMMENCED.
4. ANY PROPOSED AMENDMENTS OR VARIATIONS TO THE ORIGINAL DRAWINGS SHALL BE DISCUSSED AND APPROVED BY THE ARCHITECT.
5. ALL STRUCTURAL ELEMENTS SHALL BE DESIGNED AND CERTIFIED BY THE STRUCTURAL ENGINEER.
6. DO NOT KEEP SUPERSEDED DRAWINGS ON SITE.

Consultant Address Phone Fax e-mail	Consultant Address Phone Fax e-mail
---	---

No.	Description	Date
1	Revision 1	Date 1

Architect

C K ARCHITECTS

14 Heron Hill, Gordon NSW 2072 Ph: 02 9527 9622
Mob: 0420 922 225 Em: ckarch@bigpond.com.au Reg: Arch 4591

Client
WORTH RECYCLING
Project Name
42-46 CHARLES ST. ST. MARYS NSW

Drawing Title
TITLE SHEET & 3D VIEW

Project Status: AS BUILT

Project number: WR0113

Date: Issue Date: A100

Drawn by: Author


Revision: 1 Scale: @A3

(C) COPYRIGHT ACT: THE DESIGNS CONTAINED HEREIN REMAIN THE PROPERTY OF C.K. ARCHITECTS PTY LTD. PERMISSION MUST BE SOUGHT FOR USE OF DESIGN OR REPRODUCTION.

GENERAL NOTES

1. USE WRITTEN DIMENSIONS ONLY. THIS DRAWING SHALL NOT BE SCALED.
2. THIS DRAWING SHALL BE READ IN CONJUNCTION WITH THE SPECIFICATION.
3. ALL DIMENSIONS, AS SHOWN ON DRAWINGS, SHALL BE CHECKED AND VERIFIED BY THE BUILDER BEFORE ANY CONSTRUCTION OR FABRICATION TO BE COMMENCED.
4. ANY PROPOSED AMENDMENTS OR VARIATIONS TO THE ORIGINAL DRAWINGS SHALL BE DISCUSSED AND APPROVED BY THE ARCHITECT.
5. ALL STRUCTURAL ELEMENTS SHALL BE DESIGNED AND CERTIFIED BY THE STRUCTURAL ENGINEER.
6. DO NOT KEEP SUPERSEDED DRAWINGS ON SITE.

CHARLES STREET

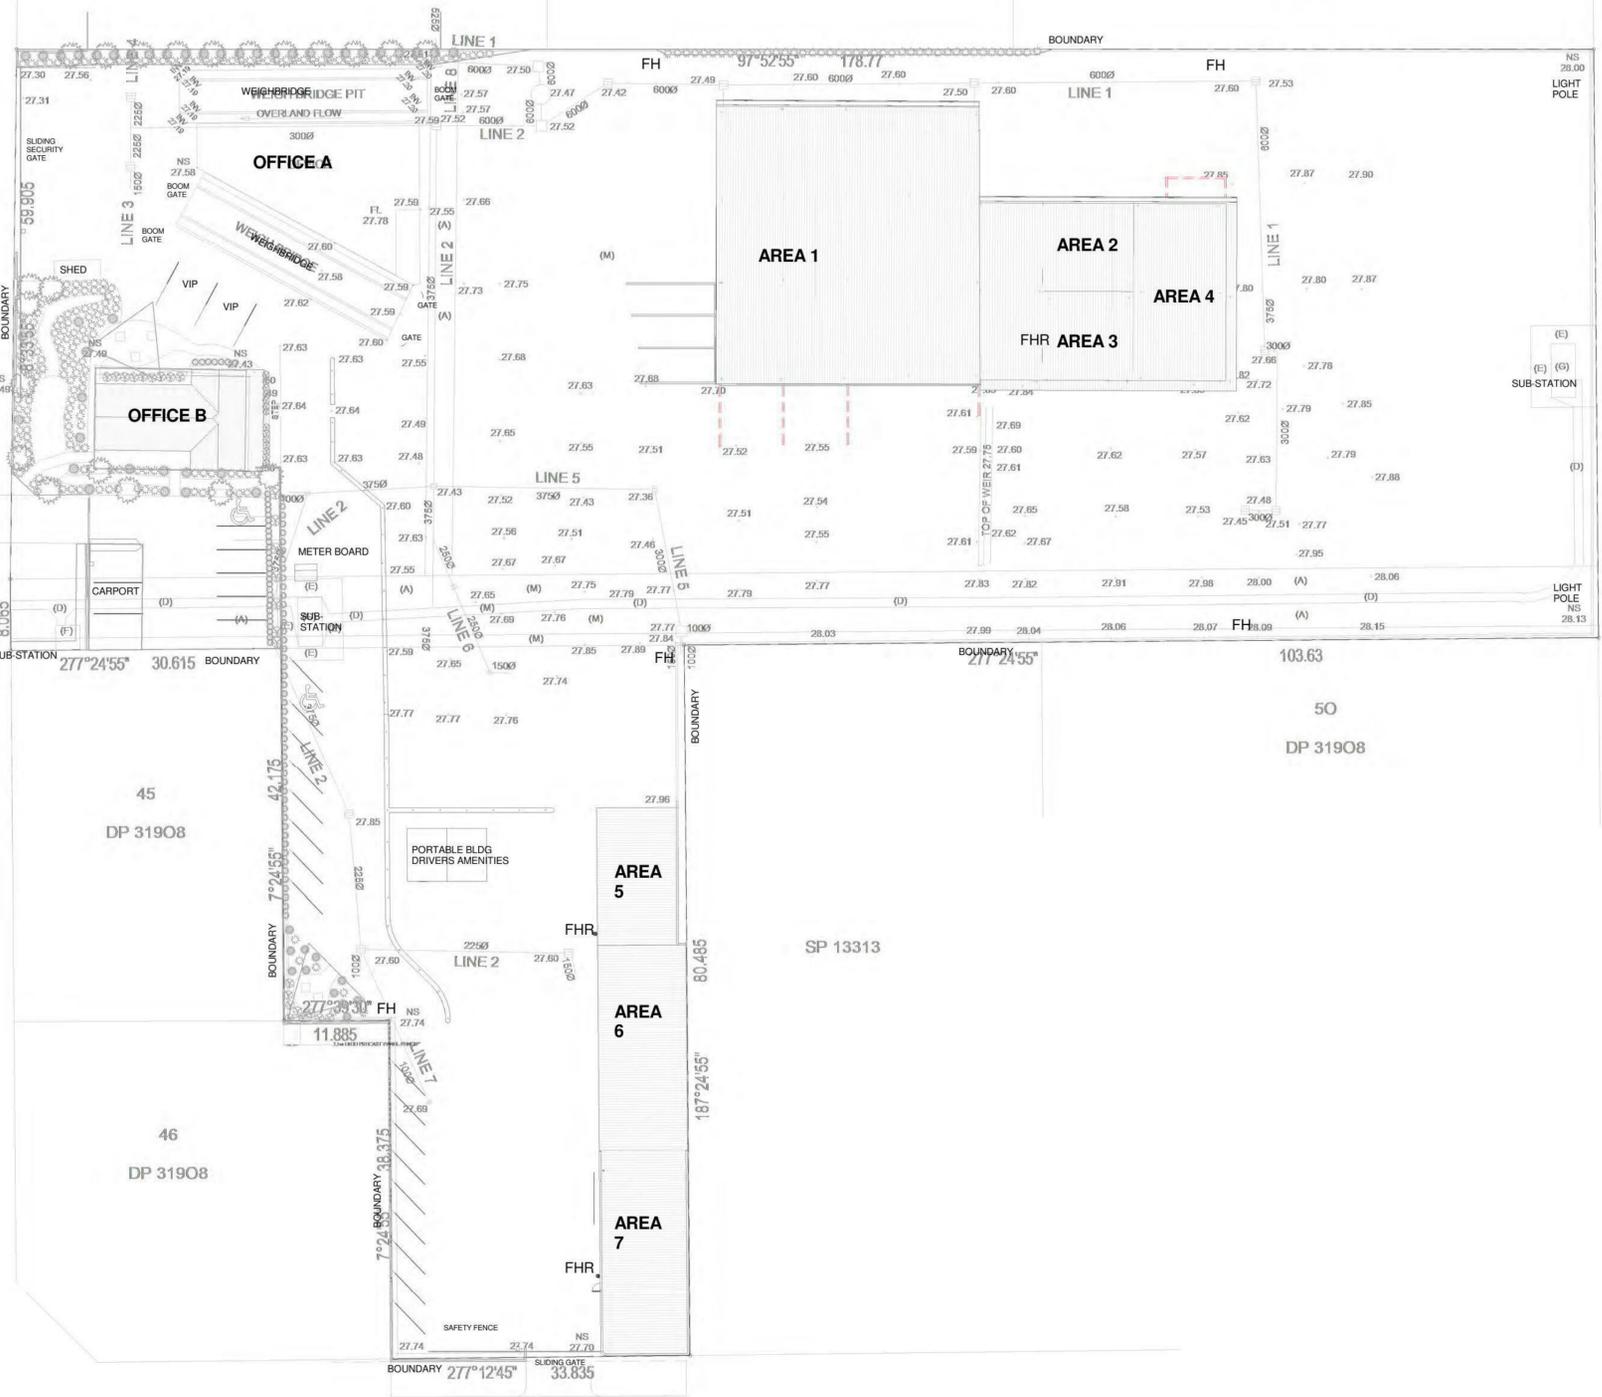

BOUNDARY 187°23'55"

DUNHEVED CIRCUIT

1 As Built Existing Site
1 : 400

LEGEND

MR	COLORBOND METAL ROOF
MC	COLORBOND METAL WALL
CL	CLADDING
FHR	FIRE HOSE REEL
FH	FIRE HYDRANT
CRP	CEMENT RENDER & PAINT
PMP	PREFINISHED METAL PANEL
CCR	CORRUGATED ZINCALUME
TR	TILED ROOF
CP	CONCRETE PANEL
CB	CONCRETE BLOCK
WH	WATER HEATER



Consultant Address	Consultant Address
Phone	Phone
Fax	Fax
e-mail	e-mail

No.	Description	Date
-----	-------------	------

Architect **C.K. ARCHITECTS**
 14 Heron Rd, Clifton NSW 2127 Ph: 02 98202300
 Mob: 0420209225 Em: ckarch@big.com.au Reg: Arch 4391


Client: WORTH RECYCLING
 Project Name: 42-46 CHARLES ST. ST MARYS NSW

Drawing Title: EXISTING AS BUILT SITE PLAN
 SCALE= 1:400


Project number	WR0113	AS BUILT
Date	Issue Date	A101
Drawn by	Author	
Revision	Scale	As indicated @A3

- NOTES:**
1. THE BUILDING LOCATIONS & DIMENSIONS & THE BOUNDARIES ARE BASED ON THE SURVEY PLAN PREPARED BY FREEBURN SURVEYING REF: 33362 DATED 23/10/12
 2. THE LANDSCAPE PLAN IS BASED ON THE CAD PLANS PROVIDED BY MONACO DESIGNS. THIS PLAN HAS BEEN MODIFIED TO FIT THE SURVEY. THEY SHOULD BE CONFIRMED BY FURTHER SURVEY.
 3. INTERNAL BUILDING WALLS AND DETAILS ARE BASED ON THE CAD PLANS PROVIDED BY WORTH RECYCLING AND HAVE BEEN MODIFIED TO FIT THE SURVEY. THEY SHOULD BE CONFIRMED BY FURTHER SURVEY.


12/03/2013 10:20:09 AM

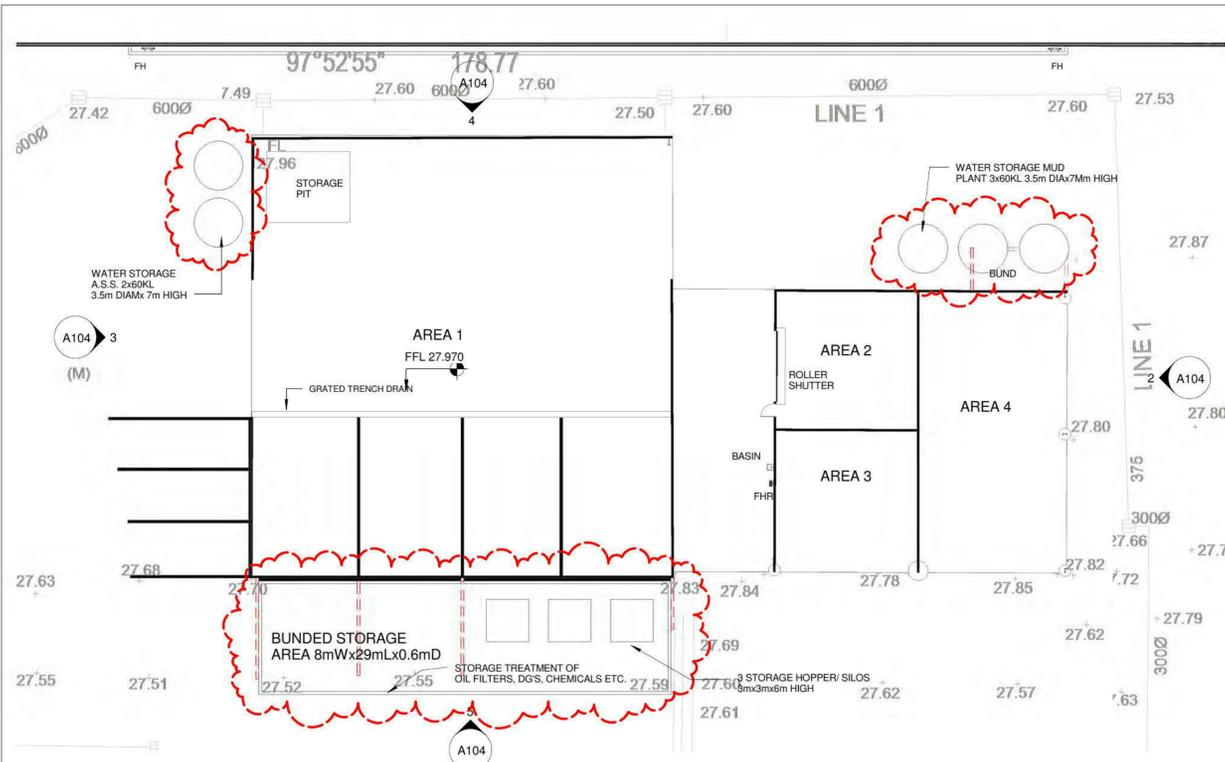


1 Area 1, 2, 3, 4 Plan
1 : 250

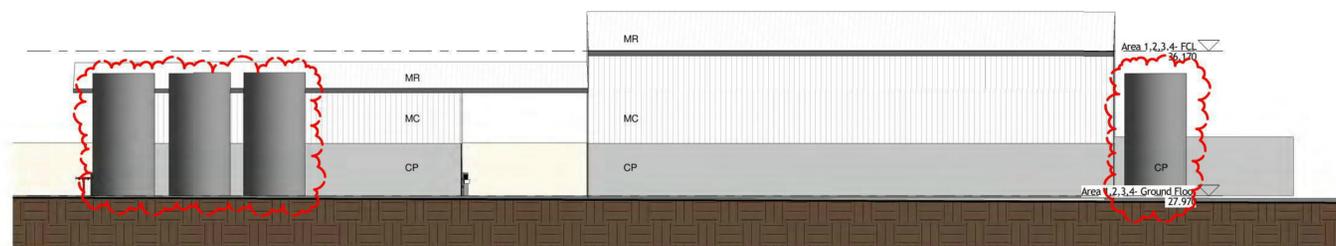


4 Area 1,2,3,4 North
1 : 200

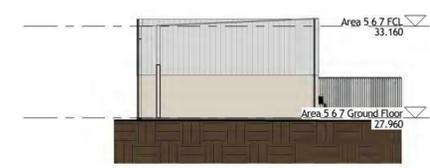


7 Area 5,6,7 North
1 : 200

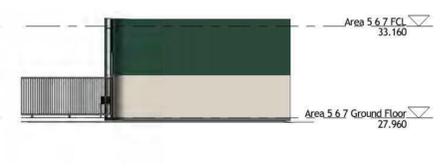


8 Area 5,6,7 South
1 : 200

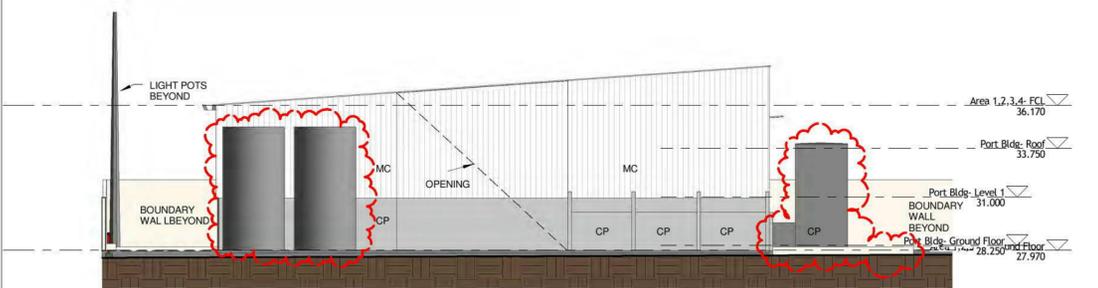


3 Area 1,2,3,4 West
1 : 200

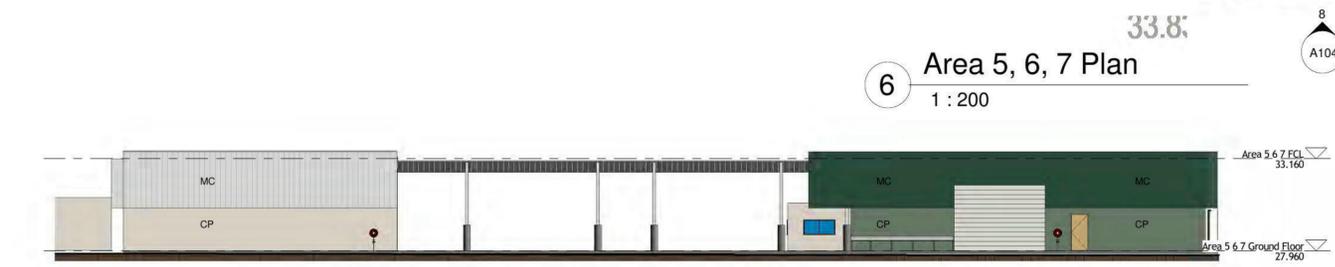

6 Area 5, 6, 7 Plan
1 : 200

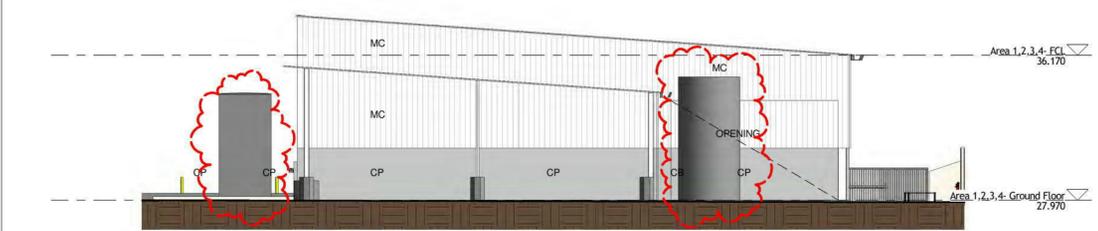

2 Area 1,2,3,4 East
1 : 200

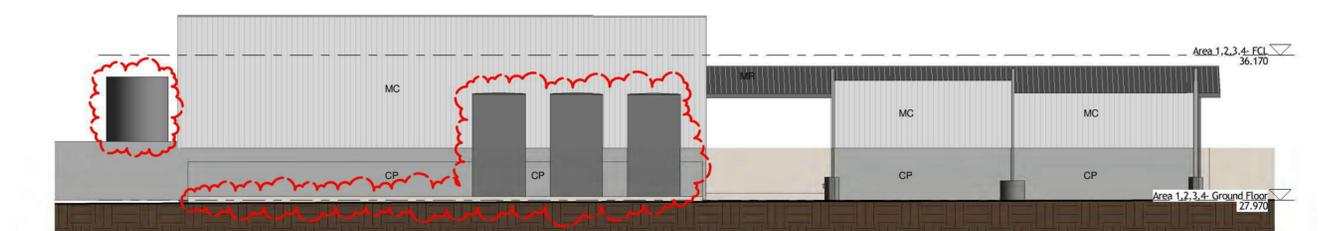

5 Area 1,2,3,4 South
1 : 200

(C) COPYRIGHT ACT: THE DESIGNS CONTAINED HEREIN REMAIN THE PROPERTY OF C.K. ARCHITECTS PTY LTD. PERMISSION MUST BE SOUGHT FOR USE OF DESIGN OR REPRODUCTION.
GENERAL NOTES
 1. USE WRITTEN DIMENSIONS ONLY. THIS DRAWING SHALL NOT BE SCALED.
 2. THIS DRAWING SHALL BE READ IN CONJUNCTION WITH THE SPECIFICATION.
 3. ALL DIMENSIONS, AS SHOWN ON DRAWINGS, SHALL BE CHECKED AND VERIFIED BY THE BUILDER BEFORE ANY CONSTRUCTION OR FABRICATION TO BE COMMENCED.
 4. ANY PROPOSED AMENDMENTS OR VARIATIONS TO THE ORIGINAL DRAWINGS SHALL BE DISCUSSED AND APPROVED BY THE ARCHITECT.
 5. ALL STRUCTURAL ELEMENTS SHALL BE DESIGNED AND CERTIFIED BY THE STRUCTURAL ENGINEER.
 6. DO NOT KEEP SUPERSEDED DRAWINGS ON SITE.

LEGEND

MR	COLORBOND METAL ROOF
MC	COLORBOND METAL WALL
CL	CLADDING
FH	FIRE HYDRANT
FHR	FIRE HOSE REEL
CRP	CEMENT RENDER & PAINT
PMP	PREFINISHED METAL PANEL
COR	CORRUGATED ZINCALUME
TR	TILED ROOF
CP	CONCRETE PANEL
CB	CONCRETE BLOCK
WH	WATER HEATER



Consultant Address	Consultant Address
Phone	Phone
Fax	Fax
e-mail	e-mail

No.	Revision	Description	Date
1	Revision 1		

ARCHITECTS
 14 Hutton Ave, Gladeside NSW 2127 Ph: 02 9529 8233
 Mob: 0420209225 Fax: 02 9529 8233
 Email: ckarch@bigpond.com.au Reg: Arch 4591


Client: WORTH RECYCLING
 Project Name: 42-46 CHARLES ST. ST. MARYS NSW

Drawing Title: AREA 1, 2, 3, 4 & 5, 6, 7

Project Status: AS BUILT

Project number: WR0113
 Date: Issue Date
 Drawn by: Author
 Revision: 1 Scale: As indicated @A3

CHARLES STREET

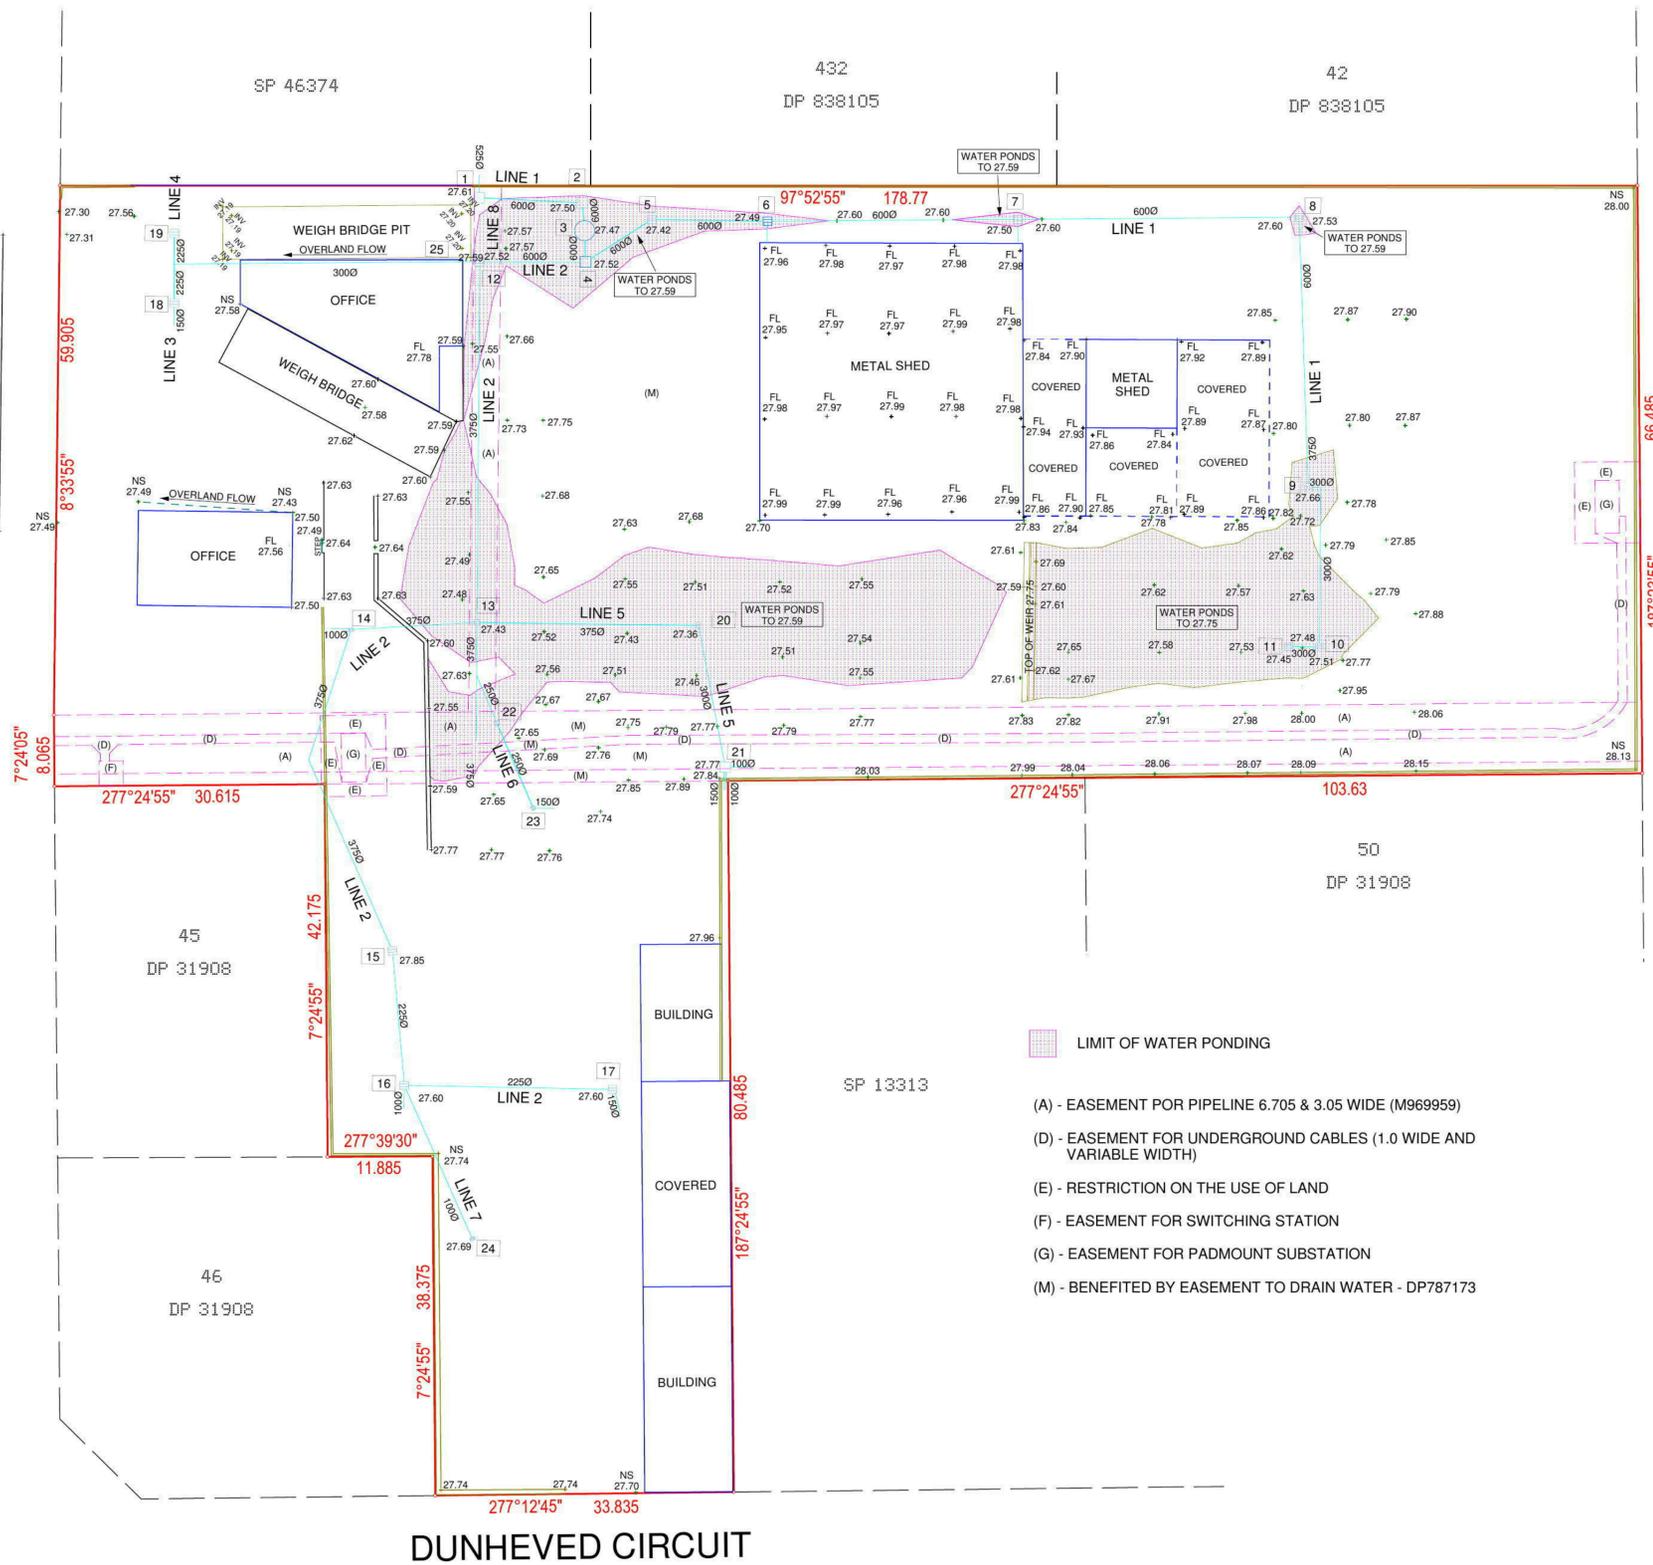


- LIMIT OF WATER PONDING
- (A) - EASEMENT FOR PIPELINE 6.705 & 3.05 WIDE (M969959)
 - (D) - EASEMENT FOR UNDERGROUND CABLES (1.0 WIDE AND VARIABLE WIDTH)
 - (E) - RESTRICTION ON THE USE OF LAND
 - (F) - EASEMENT FOR SWITCHING STATION
 - (G) - EASEMENT FOR PADMOUNT SUBSTATION
 - (M) - BENEFITED BY EASEMENT TO DRAIN WATER - DP787173

NOTES:

- * The position of features are indicative only.
- * 101.50 indicates natural surface level.
- * Relationship of improvements to boundaries is diagrammatic only. Where offsets are critical they should be confirmed by further survey.
- * Bearings and distances are by title only. No boundary investigation has been carried out.

NOTE
ALL DISTANCES AND AREAS
ARE SUBJECT TO FINAL SURVEY

ORIGIN OF LEVELS:- floor level of office 27.56 adopted

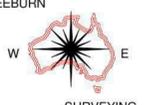Client: Steve Matthews WORTH RECYCLING 42 -46 CHARLES ST ST MARYS NSW	Project: PLAN SHOWING DETAIL & LEVELS OVER LOT 300 IN DP 1143213 KNOWN AS N° 42 - 46 CHARLES STREET, ST MARYS	FREEBURN  SURVEYING	MATTHEW FREEBURN LAND, ENGINEERING & MINING SURVEYOR SUITE 2, FIRST FLOOR, "SURVEYOR HOUSE" 2 CASTLEREAGH STREET PENRITH 2750	Telephone 02 4721 2289 Fax 02 4721 5646 email matthew@freeburnsurveyors.com	Date: 23/10/2012	Ref: 33362	Sheet 1 of 1
					Scale 1: 400	Datum: Assumed	Contour: N/A
					Surveyor: DF/TB	Drawn By: DF	Checked: MF
					CC7 - SURVEY 5 - DWG A1-400		A1 SHEET