

STREETSCAPE MOUNT VERNON ROAD ELEVATION

ABBREVIATION	DESCRIPTION	LOCATION	FINISH
STC.01	STONE CLADDING 'DESERT STORM'	EXTERNAL WALLS	
TBR.01	TIMBER CLADDING 'WEATHERTEX' WEATHERGROOVE 150	EXTERNAL WALLS	
PRP.01	ACRATEX 3 STEP COATING SYSTEM TO POWER PANELS	EXTERNAL WALLS	
R.01 F.01 B.01 G.01 HR.01 PCA.01	COLORBOND METAL 'DUNE'	CORRUGATED ROOF SHEETS GUTTER FASCIA BARGE BOARD HANDRAIL WINDOWS	
DK.01	MODWOOD ECO DECK	VERANDAH, BOARDWALK & GAZEBO	
SCN.01	MODWOOD ECO DECK	SUB-FLOOR SCREEN	
TP.01	TIMBER POST CLADDING 'MERBAU'	VERANDAH, BOARDWALK & GAZEBO	

ARCHI	TECTURAL DRAWING	LIST
DRAWING NO.	NAME	SCALE
DA00	COVER SHEET	NTS
DA01	SITE PLAN	1:200 1:400
DA01	CONTEXTUAL SITE PLAN	1:1000
DA02	SITE ANALYSIS AND MANAGEMENT PLAN	1:400
DA03	FLOOR PLAN	1:100
DA04	ROOF PLAN	1:100
DA05	ELEVATIONS & SECTION	1:100
DA06	COMMERCIAL KITCHEN DETAIL PLAN ELEVATIONS AND SECTIONS	1:50
DA07	NOTES	NTS
DA08	PHOTOMONTAGE - SHEET 1	NTS
DA09	PHOTOMONTAGE - SHEET 2	NTS
DA10	PHOTOMONTAGE - SHEET 3	NTS
DAII	PHOTOMONTAGE - SHEET 4	NTS

Issue	Description	Date
Α	Finishes Schedule amended	25.03.20
	- Colorbond roof cladding	
	- Wall cladding colour	



Project Works Design Pty Ltd

ABN 97 108 707 482

This drawing is C a. p.o. box 5138 chittaway bay nsw 2261 p. 0412 637 875 admin@pwdesign.com.au

This drawing is Copyright and is the property of Project Works Design Pty Limited. It must not be copied or reproduced in any way without the written permission of Project www.pwdesign.com.au Works Design Pty Limited

Rev Date Description Amendments

Vladimir Vanovac and Mark Toma

Proposed Childcare Centre 110 - 112 Mount Vernon Road Mount Vernon NSW

Title: Cover Sheet Checked: GM

North Point Date: 20.04.2020

DA00 Job No. 18307

Version: 1, Version Date: 08/01/2021



Project Works Design Pty Ltd
ABN 97 108 707 482 a. p.o. box 5138 chittaway bay nsw 2261 p. 0412 637 875 admin@pwdesign.com.au


This drawing is Copyright and is the property of Project Works Design Pty Limited. It must not be copied or reproduced in any way without the written permission of Project www.pwdesign.com.au Works Design Pty Limited


Vladimir Vanovac and Mark Toma

Proposed Childcare Centre 110 - 112 Mount Vernon Road Mount Vernon NSW


Contextual Site Plan Checked: GM DA01.1

Scale: 1:1000@A1

 

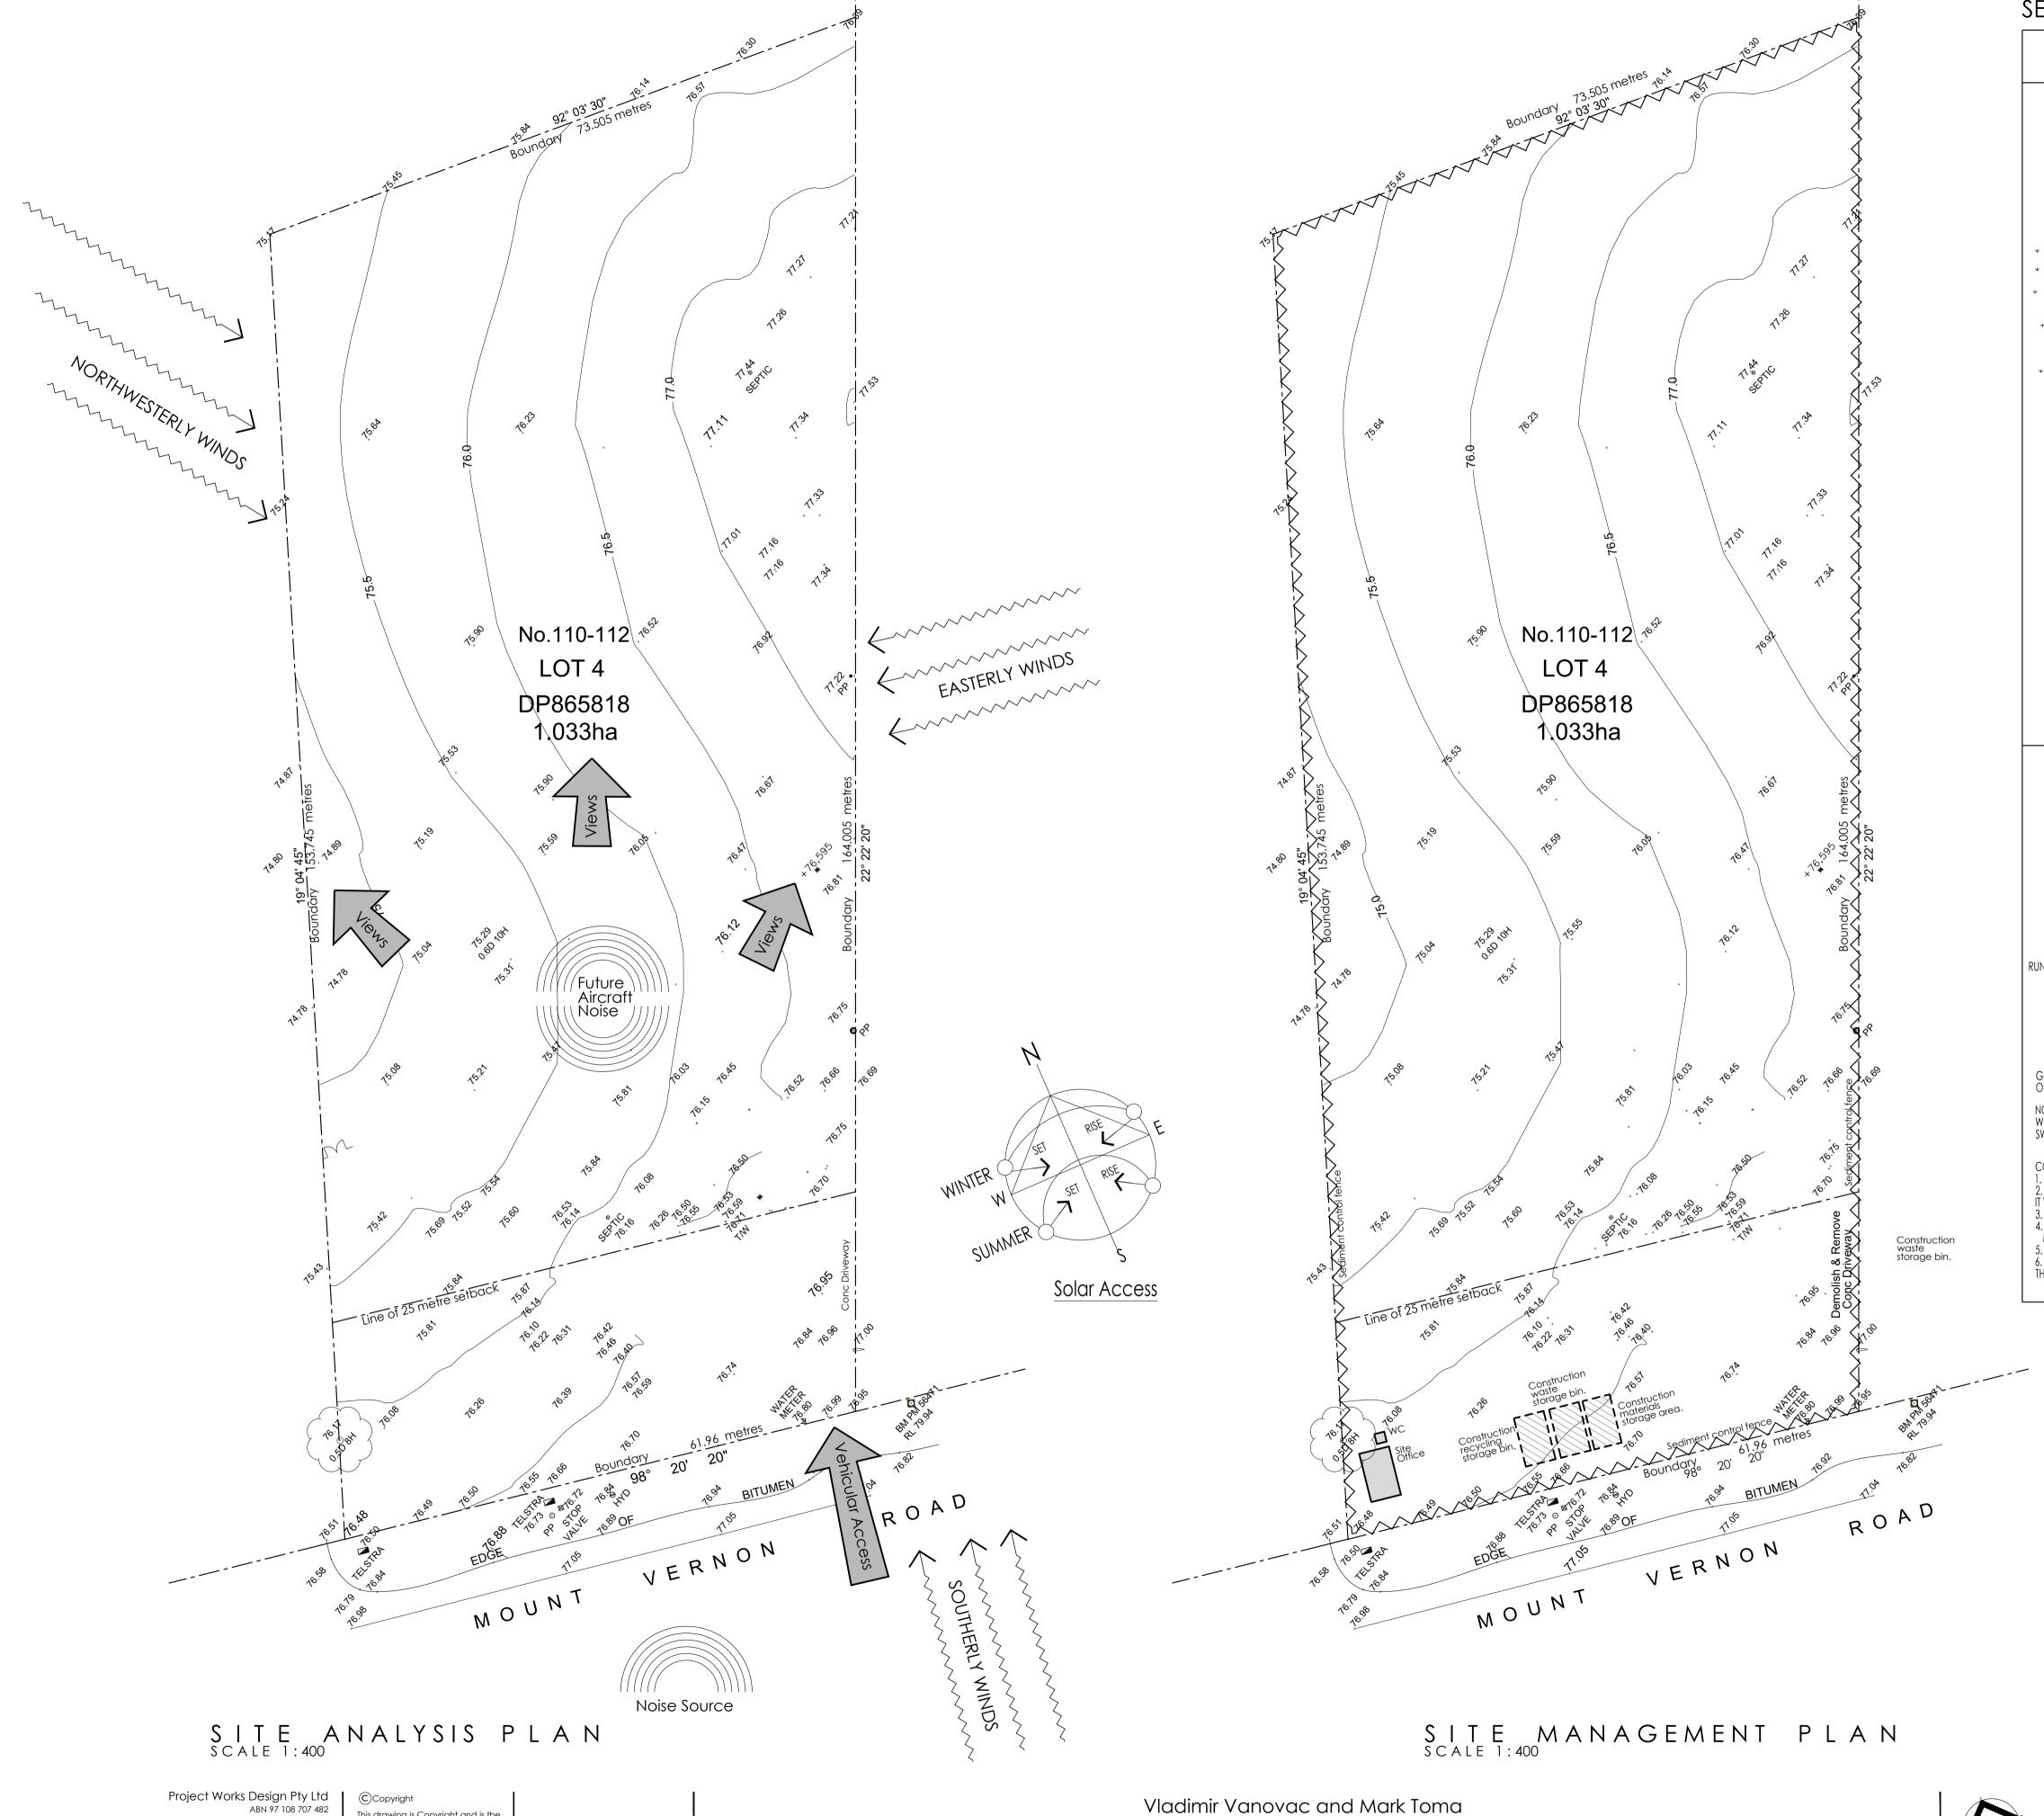



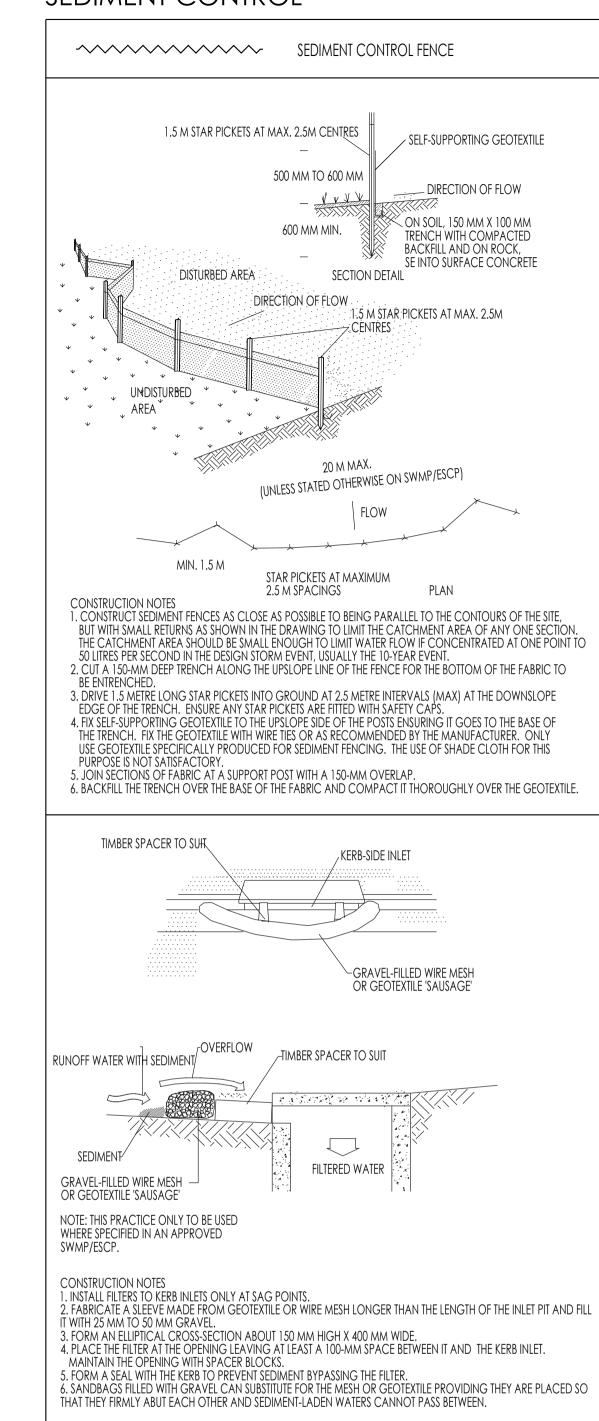

0 2 4 6 8 10 SCALE - 1:400 @ A1

Site Analysis Plan and Site Management Plan

Date: 20.04.2020

Checked: GM

Scale: 1:400 @A1

DA02

Job No. 18307

Vladimir Vanovac and Mark Toma


a. p.o. box 5138


p. 0412 637 875

chittaway bay nsw 2261

admin@pwdesign.com.au


www.pwdesign.com.au

 


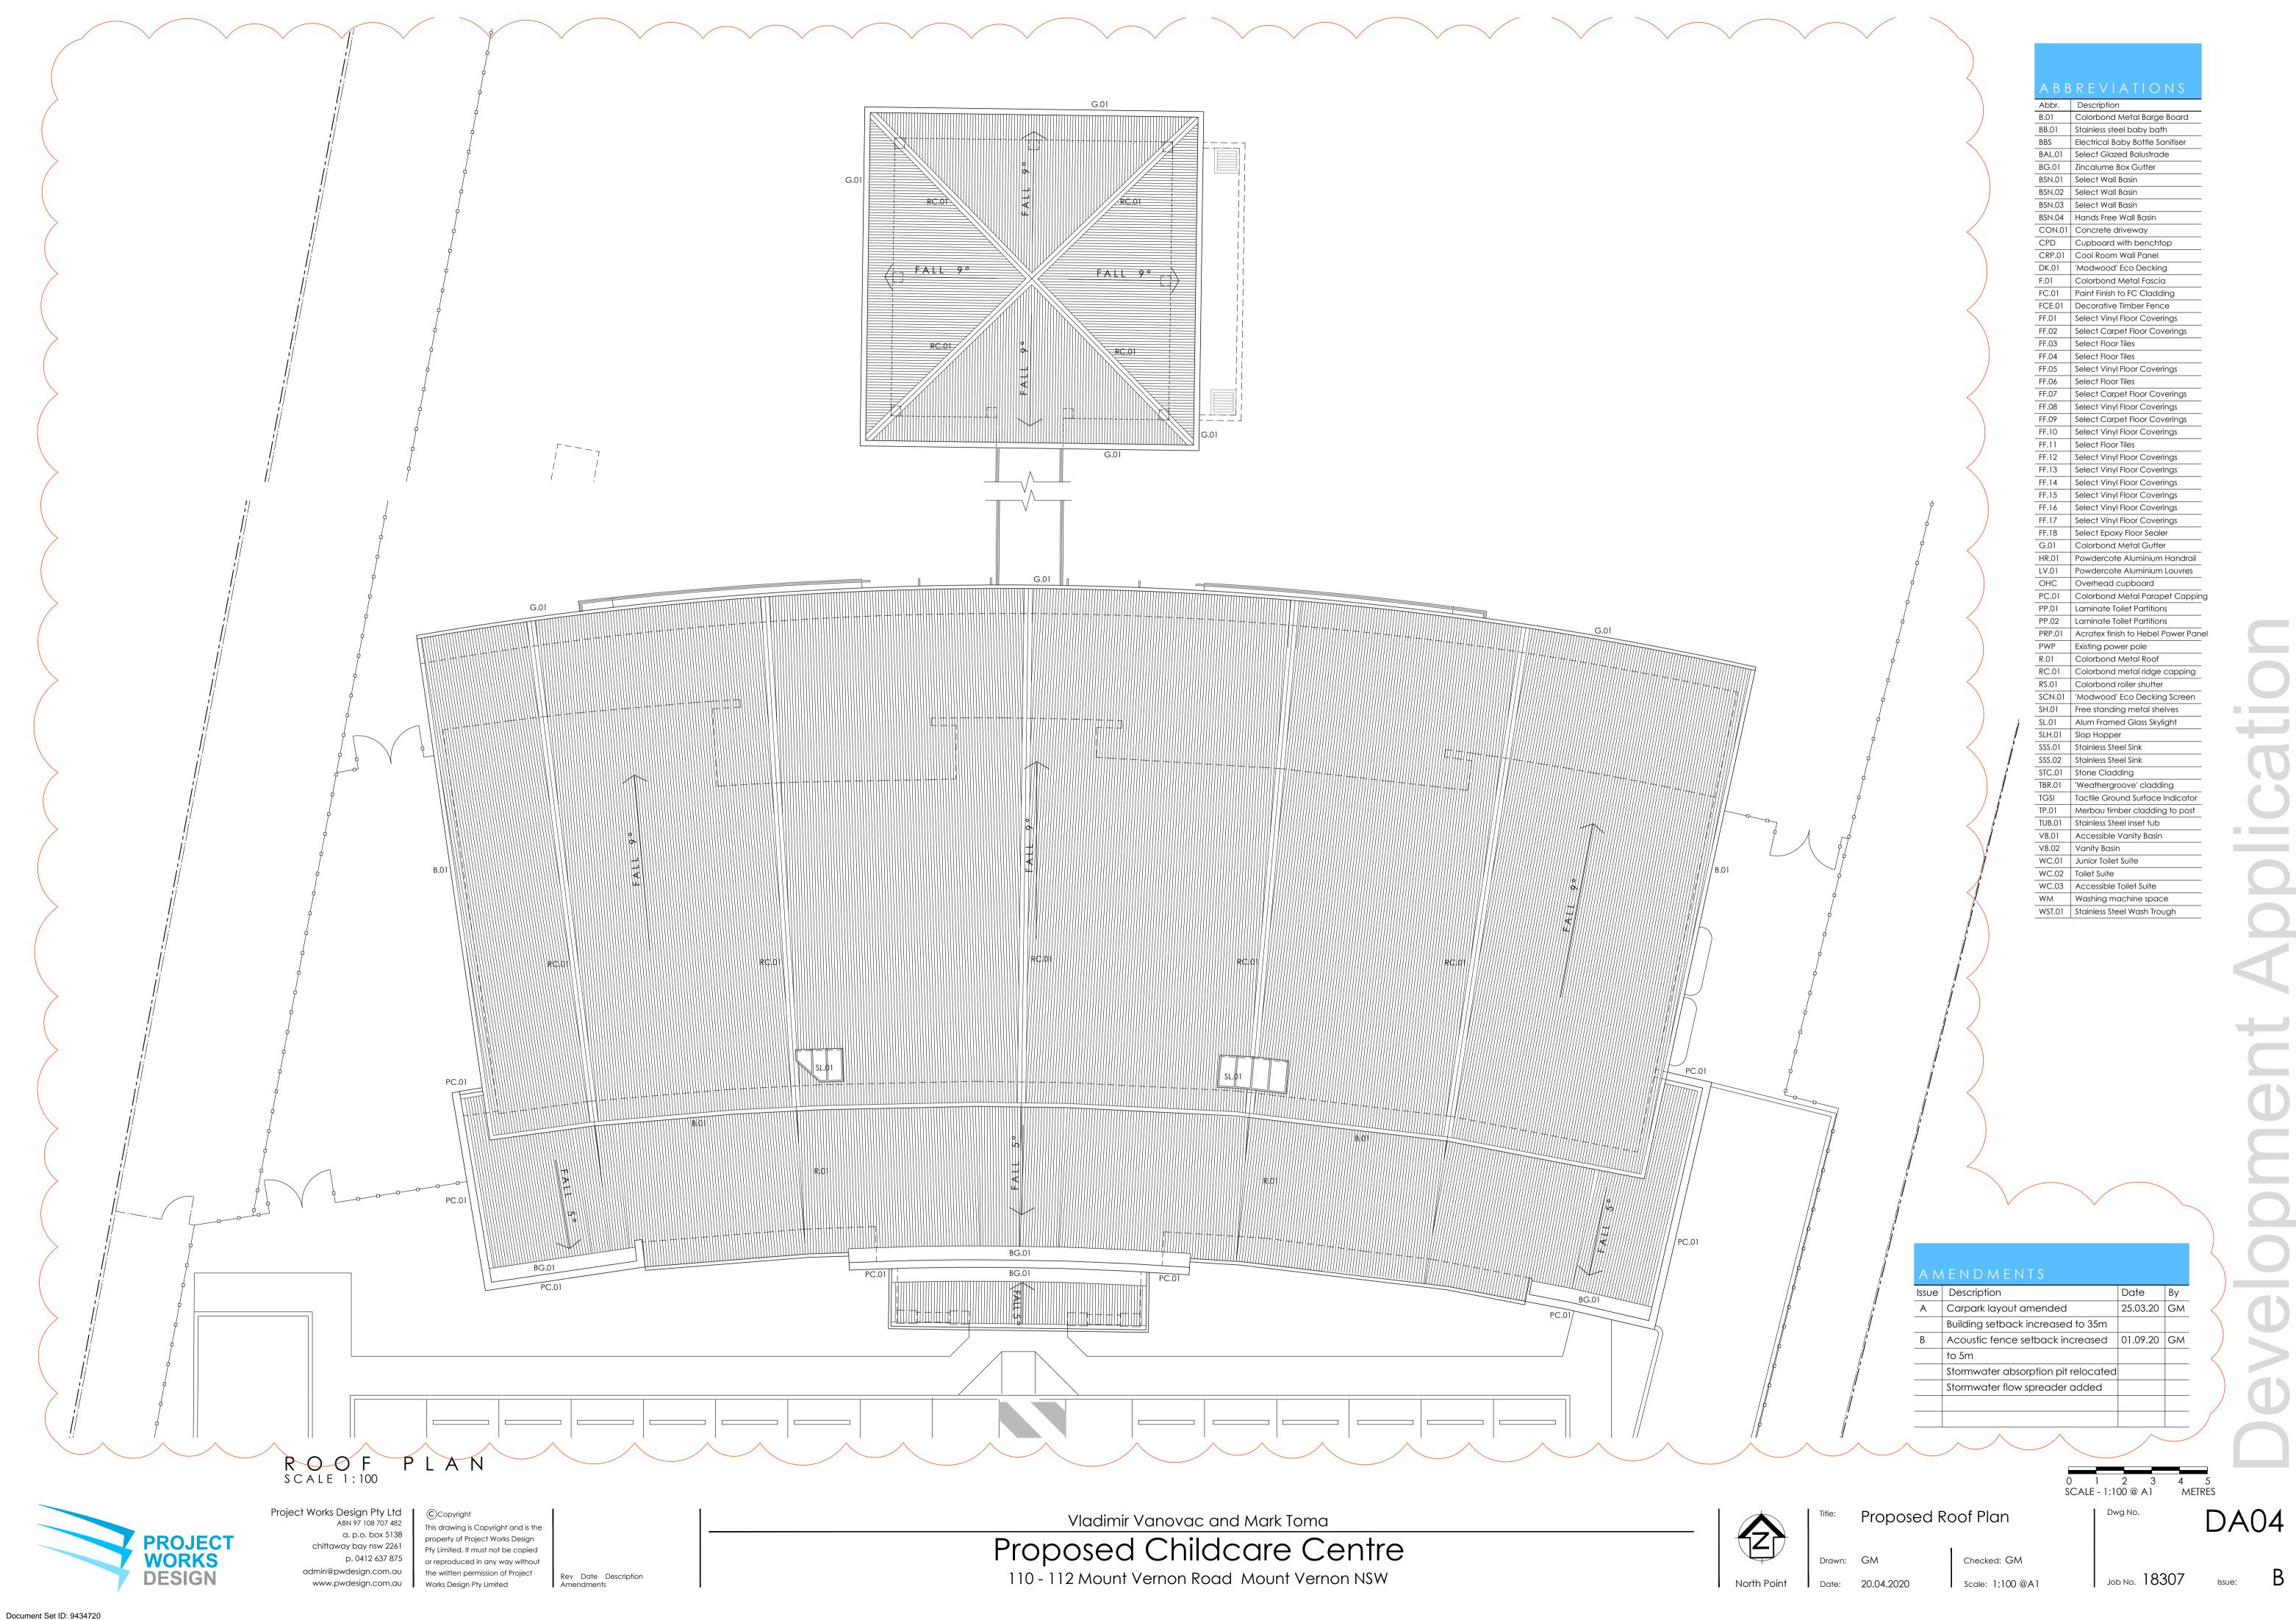

Version: 1, Version Date: 08/01/2021



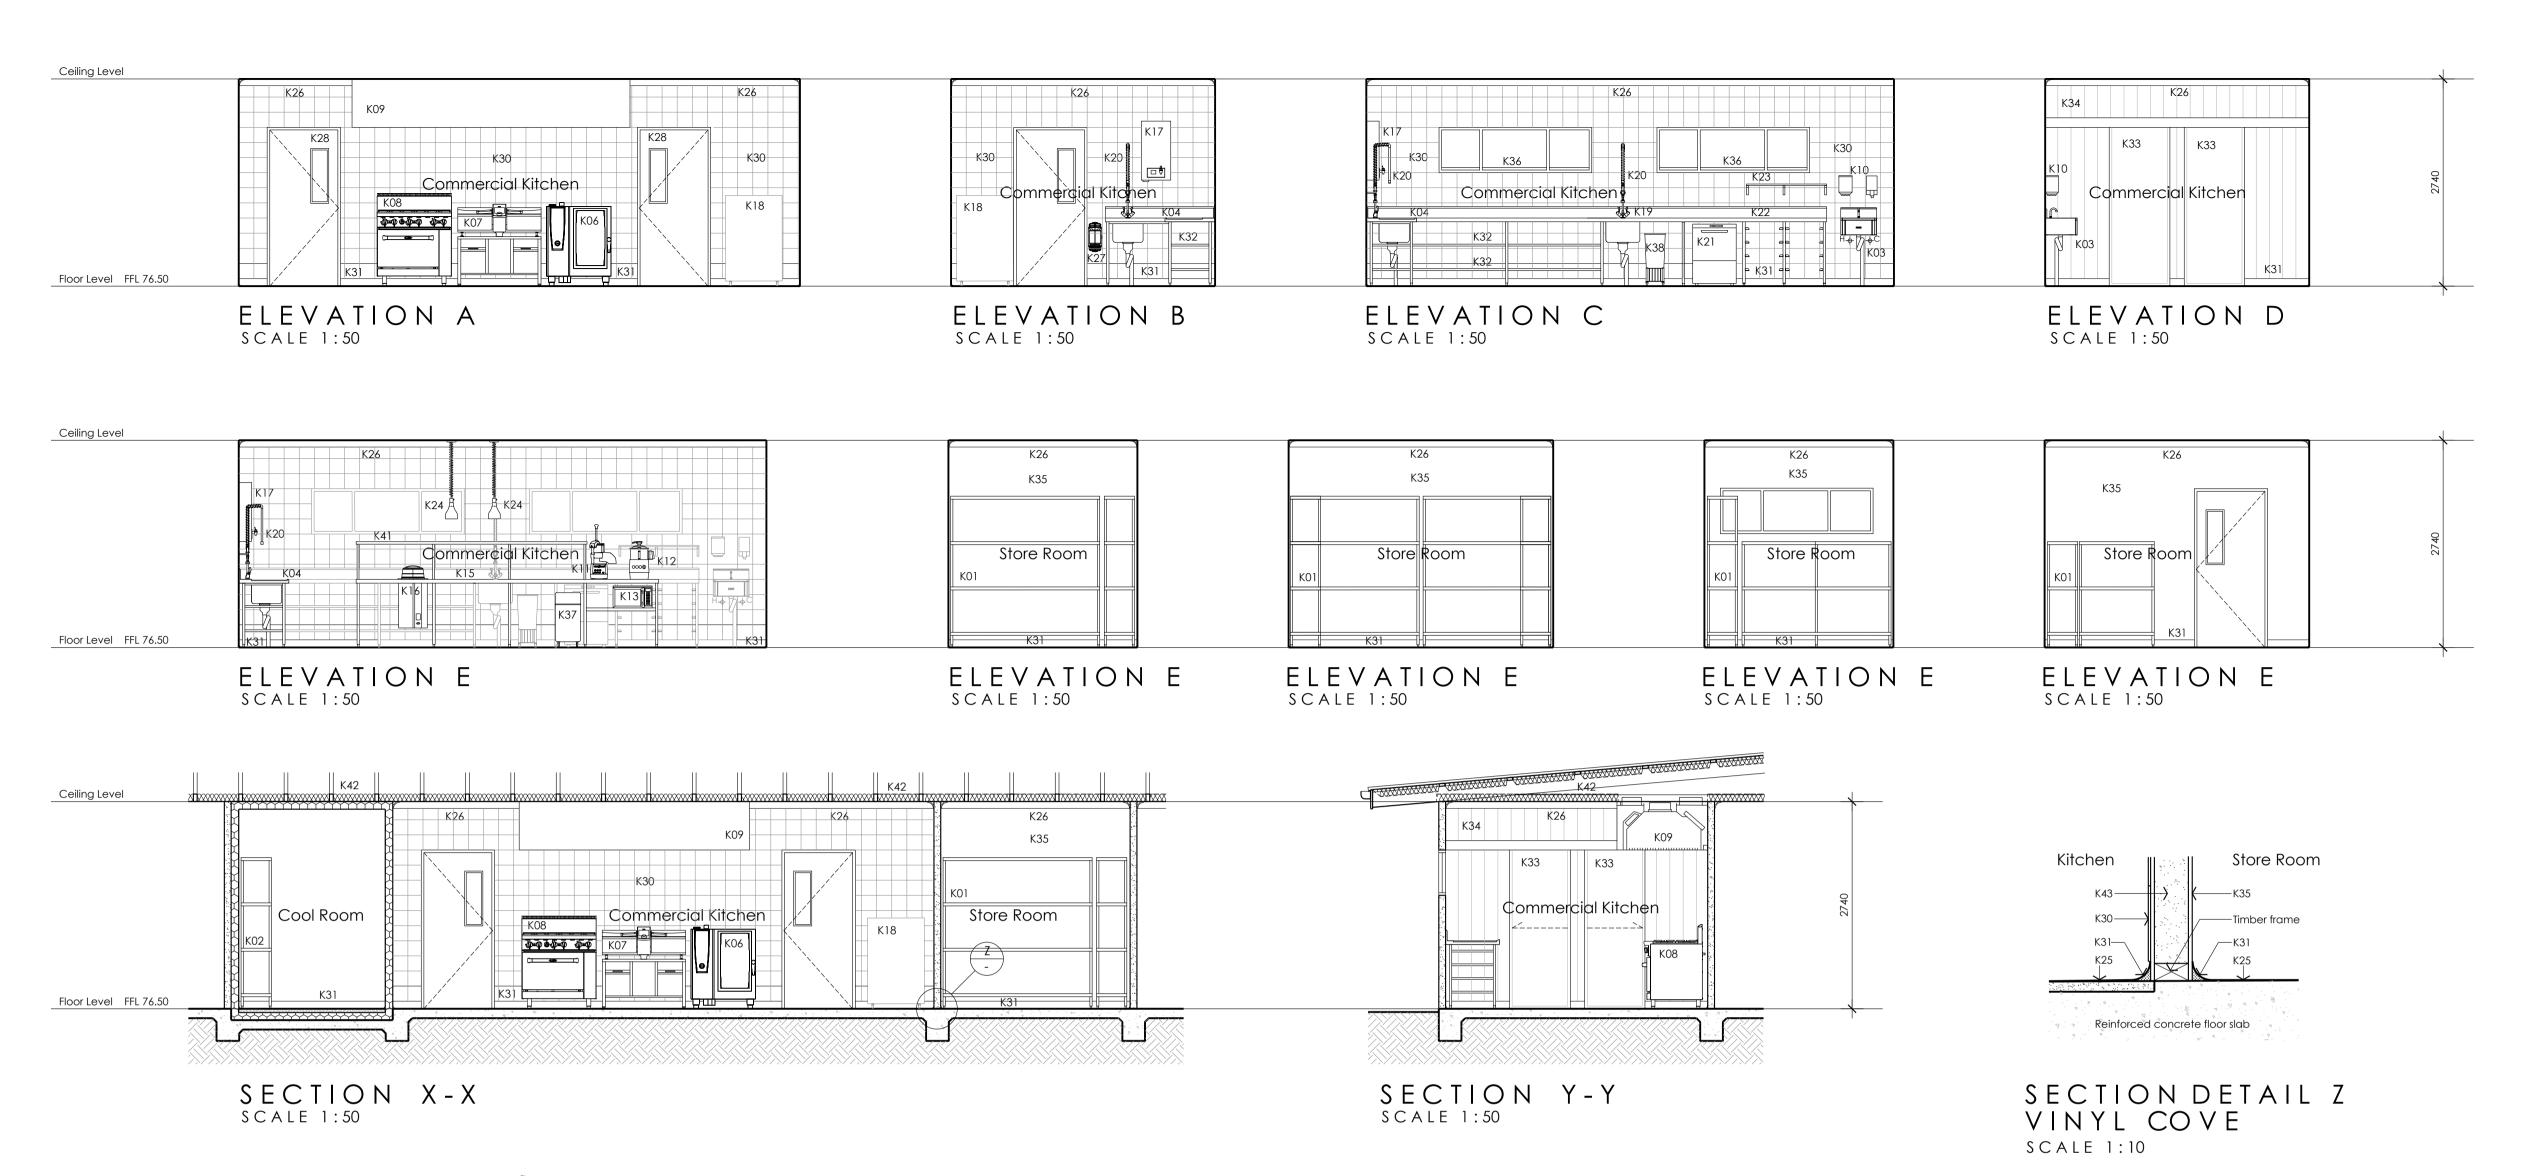

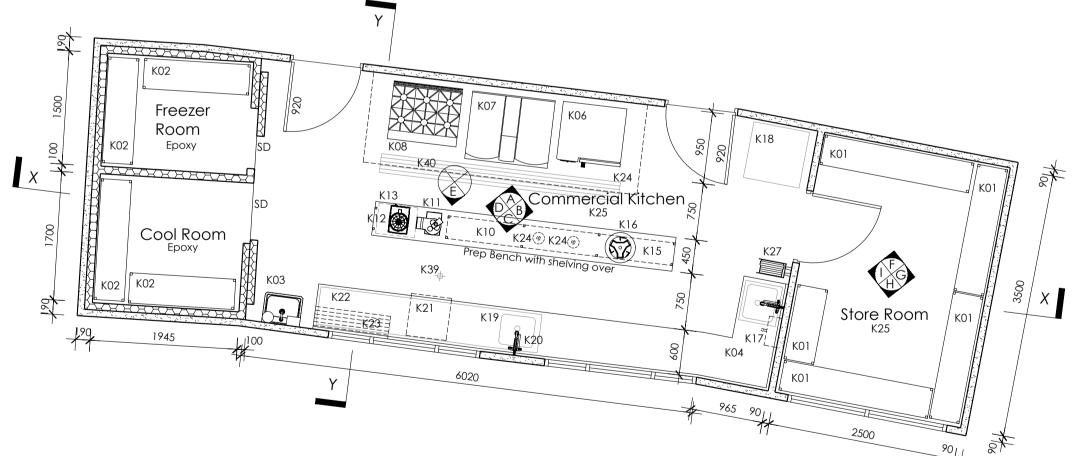

COMERCIAL KITCHEN PLAN

ABN 97 108 707 482

a. p.o. box 5138

p. 0412 637 875

chittaway bay nsw 2261

admin@pwdesign.com.au

Vladimir Vanovac and Mark Toma

Proposed Childcare Centre 110 - 112 Mount Vernon Road Mount Vernon NSW

Commercial Kitchen Detail Plan Elevations Checked: GM Date: 20.04.2020 Scale: 1:50 @A1

ITEM NO. DESCRIPTION K01 Dry Store Racking

K03 Hands Free Wash Basins

K05 S.S. 2 Tier Overshelf

K06

K09

K13

K26

K27

K38

K11 Blixer

K12 Food Processor

K14 Stick Blender

K16 Plate Warmers

Hose Reel

Ingredients Bin

Waste Bin Floor Waste

Grated Drain

Serving Shelf K42 Ceiling Insulation

KO4 S.S. Wet/Dry Prep Bench

10 Tray Combi Oven

K08 6 Burner Cooktop and Oven

Extraction Canopy

Commercial Microwave

VCC Multi-Function Appliance

K10 Soap dispenser and Paper Towel Dispenser

K02 Cool Room / Freezer Room Storage Racking

DA06 Job No. 18307

PROJECT WORKS **DESIGN** 

Project Works Design Pty Ltd ©Copyright This drawing is Copyright and is the oroperty of Project Works Design Pty Limited. It must not be copied or reproduced in any way without the written permission of Project Works Design Pty Limited

# SECTION J NOTES

### Part J1 - Building Fabric

1. Construction Requirements - Installation of Insulation Where required, insulation must comply with AS/NZS 4859.1 and be installed so that it: abuts or overlaps adjoining insulation other than at supporting members; and

forms a continuous barrier...and (iii) does not affect the safe or effective operation of a service or fitting.

Reflective insulation must be installed with: the necessary airspace to achieve the required R-Value between a reflective side

of the reflective insulation and a building lining or cladding; and (ii) the reflective insulation closely fitted against any penetration, door or window opening; and

(iii) the reflective insulation adequately supported by framing members: and (iv) each adjoining sheet of roll membrane being overlapped not less than 50 mm or

Bulk insulation must be installed so that: (i) it maintains its position and thickness, other than where it crosses roof battens, water pipes, electrical cabling or the like; and

(ii) in a ceiling, where there is no bulk insulation or reflective insulation in the wall beneath, it overlaps the wall by not less than 50 mm.

2. Construction Requirements - Roof and Ceiling Insulation The minimum total R-Value for the roof/ceiling system which forms part of the envelope required by BCA Table J1.3a is R3.2.

The proposed roof/ceiling system achieves an R-Value of R0.47. Therefore to achieve compliance, insulation of at least R2.73 is required to be incorporated into the roof/ceiling system which forms part of the envelope.

3. Construction Requirements - Adjustment for Loss of Ceiling

Where the required insulation is located at ceiling level and the percentage of ceiling area uninsulated is more than 0.5% as a result of loss of ceiling insulation due to operational or safety reasons and where insulation of more than R1.0 is located at ceiling level, the loss of insulation must be compensated for by increasing the R-Value of the insulation in the remainder of the ceiling in accordance with BCA Table J1.3b.

Note: The percentage of ceiling area uninsulated must not exceed 5% of the total ceiling area forming part of the envelope.

4. Construction Requirements - Thermal Break Where the ceiling lining is attached directly to the same metal frame as the metal roof, a thermal break of at least R0.2 must be installed between the metal sheet roofing and its supporting metal frame. This applies to areas of roof that form part of the envelope.

5. Construction Requirements - Wall Insulation (External Envelope) Where external walls form part of the envelope, a total R-value of R2.8 is required to be achieved. The metal stud walls achieve an R-value of R0.22. Therefore, insulation with R-value of at least R2.58 is required to be incorporated into the metal stud wall system where walls form part of the external envelope. See Appendix for walls forming part of the envelope.

6. Construction Requirements - Wall Insulation (Internal Envelope) Where internal walls form part of the envelope, a total R-value of R1.8 is required to be

The stud walls achieve an R-value of R0.33. Therefore, insulation with R-value of at least R1.47 is required to be incorporated into the stud wall system where walls form part of the internal envelope.

See Appendix for walls forming part of the envelope. Construction Requirements - Thermal Breaks A thermal break with R-Value of not less than R0.2 must be installed between the external cladding and the metal frame of walls that have lightweight external cladding fixed to a

metal frame and have a wall lining fixed directly to the same metal frame where walls form 8. Construction Requirements - Floor Insulation

The total R-value required to be achieved by an on-ground concrete slab with no in-slab

Part J2 - Glazing

#### 9. Construction Requirements - Glazing Glazing elements forming part of the envelope shall have the following thermal properties

heating or cooling in climate zone 6 is: NIL

in terms of their orientations:

Orientation	Item	Total U Value	SHGC
South	Glazing	Equal or Lower than 5.4	Equal or Higher than 0.31
East	Glazing	Equal or Lower than 8.0	Equal or Lower than 1.0
North	Glazing	Equal or Higher than 3.2	Equal or Lower than 0.54
West	Glazing	Equal or Lower than 6.0	Equal or Lower than 0.99

#### Refer to Appendix for full calculation of glazing requirements. 10. Construction Requirements - Shading Shading has been provided as shown on architectural drawings by building elements and

shading projections. For further details refer to the glazing calculations in Appendix (see P and H values). No alterations shall be made to shading design dimensions without first checking compliance with this Clause. Contact Application Solutions for assistance if required.

Part J3 - Building Sealing

11. Construction Requirements - Window and Door Sealing

A seal to restrict air infiltration must be fitted to each edge of a door, openable window or the like where forming part of the envelope. The seal may be a foam or rubber compression strip, fibrous seal or the like. For the bottom edge of an external swing door, a draft protection device must be installed.

For exemptions to this clause see body of report. 12. Construction Requirements - Building Entrance Sealing An entrance to a building leading to a conditioned space must have an airlock, self-closing door, revolving door or the like.

13. Construction Requirements - Exhaust Fan Sealing A miscellaneous exhaust fan such as a bathroom or domestic kitchen exhaust fan, must be fitted with a sealing device such as a self-closing damper or the like when serving a conditioned space.

14. Construction Requirements - Roof, Wall and Floor Sealing Roofs, ceilings, walls, floors and any opening such as a window frame, door frame, or the like must be constructed to minimise air leakage when forming part of the envelope and must be enclosed by internal lining systems that are close fitting at ceiling, wall and floor

## Part J5 - Air-conditioning and Ventilation Systems

junctions or sealed by caulking, skirting, architraves, cornices or the like.

15. Construction Requirements - Deactivation Capability An air-conditioning system must be capable of being deactivated when the building or part of the building served is not occupied.

16. Construction Requirements - Air-conditioning Zones Different air-conditioning zones shall be separately thermostatically controlled and not have their temperature controlled by mixing actively heated air or actively cooled air. Reheating must be limited to not more than a 7.5K rise in temperature for a fixed supply air rate, or for a variable supply air rate, not more than 7.5K rise in temperature at the normal supply air rate but increased or decreased at the same rate that the supply air rate is respectively decreased or increased.

17. Construction Requirements - Economy Cycle Where the air-conditioning system provides the required mechanical ventilation and exceeds 35 kWr, it shall have an outdoor air economy cycle.

18. Construction Requirements - Air Dampers Where the air-conditioning unit or system has motorised outside air and return dampers, close the dampers when the air-conditioning unit or system is deactivated. 19. Construction Requirements - Air-conditioning Fans

Fans of any air-conditioning systems serving the building must comply with BCA Specification J5.2a. 20. Construction Requirements - Ductwork Insulation

The ductwork of an air-conditioning system must be insulated and sealed in accordance with BCA Specification J5.2b. 21. Construction Requirements - Energy Efficiency Ratios Any packaged air-conditioning equipment or refrigerant chillers (as part of an

air-conditioning system) must have energy efficiency ratios in compliance with BCA Specification J5.2e. 22. Construction Requirements - Time Switch A time switch in accordance with BCA Specification J6 must be provided to control all

air-conditioning/heating systems of more than 10 kW. 23. Construction Requirements - Ventilation Operation A mechanical ventilation system (including one which is part of an air-conditioning system) must be capable of being deactivated when the building or part of the building served is

not occupied. 24. Construction Requirements - Mechanical Ventilation of Conditioned

The mechanical ventilation system shall not provide mechanical ventilation in excess of the minimum quantity required by BCA Part F4 by more than 20% other than in the conditions detailed in the body of the report.

25. Construction Requirements - Ventilation Fans Any fans of a mechanical ventilation system installed must comply with BCA Specification

26. Construction Requirements -Ventilation Time Switch Control Any mechanical ventilation system with an air flow rate of more than 1000 L/s must be controlled by a time switch in compliance with BCA Specification J6.

See BCA J5.3(c)(ii) for any appropriate exclusions to this requirement. 27. Construction Requirements - Miscellaneous Exhaust An exhaust system which has an air flow rate of more than 1000 L/s and is associated with equipment having a variable demand must have the ability for the operator to stop the

motor when the system is not in use and must also have a variable speed fan (or similar

Part J6 - Artificial Lighting and Power

control system).

28. Construction Requirements - Maximum Interior Illumination Power

The total maximum allowed interior illumination power load for the development is 6,446

The aggregate design illumination power load must not exceed this allowed wattage. Note emergency lighting and signage lighting are exempted from this requirement. See Appendix for detailed calculation of allowed interior illumination power load. 29. Construction Requirements - Lighting Control Artificial lighting of a room or space must be individually operated by a switch or other

control device. 30. Construction Requirements - Lighting Control (Switching) Artificial lighting switches must be located in a visible position in the room or space being switched or in an adjacent room or space from where the lighting being switched is visible. Switches must not operate lighting for an area of more than 250 m2. 31. Construction Requirements - Time Switch or Occupant Sensing

95% of the lighting in the building must be controlled by a time switch in accordance with BCA Specification J6 or an occupant sensing device such as a security card reader that registers a person entering and leaving the building or a motion detector in accordance with BCA Specification J6.

32. Construction Requirements - Decorative or Display Lighting Interior decorative and display lighting (such as for foyer mural art display), shall be controlled separately from other lighting by a manual switch for each area (where the operating times of the displays are the same in multiple areas, they may be combined). Where the decorative/display lighting exceeds 1 kW, it must be controlled by a time switch in accordance with BCA Specification J6.

33. Construction Requirements - Window Display Lighting Window display lighting must be controlled separately from other display lighting. 34. Construction Requirements - Perimeter Lighting Artificial lighting around the perimeter of the building must be controlled by a daylight sensor or a time switch in accordance with BCA Specification J6. When the total perimeter lighting load exceeds 100 W it shall have an average light source


efficacy of not less than 60 Lumens/W or be controlled by a motion detector in accordance with BCA Specification J6. 35. Construction Requirements - Decorative Perimeter Lighting Where external lighting for decorative or signage purposes is installed, it must be controlled by a time switch (separate from other external lighting) in accordance with BCA

36. Construction Requirements - Boiling/Chilled Water Storage Units The power supply to a boiling water or chilled water storage unit must be controlled by a time switch in accordance with BCA Specification J6. Part J7 - Heated Water Supply and Swimming Pool and Spa Pool

37. Construction Requirements - Hot Water Heater

record the consumption of gas and electricity.

Any heated water service for food preparation or sanitary purposes must be designed and installed in accordance with Part B2 of NCC Volume Three - Plumbing Code of Australia. Part J8 - Access for Maintenance and Facilities for Monitoring 38. Construction Requirements - Gas and Electricity Consumption The building has a floor area of more than 500 m<sub>2</sub> and therefore must have the facility to

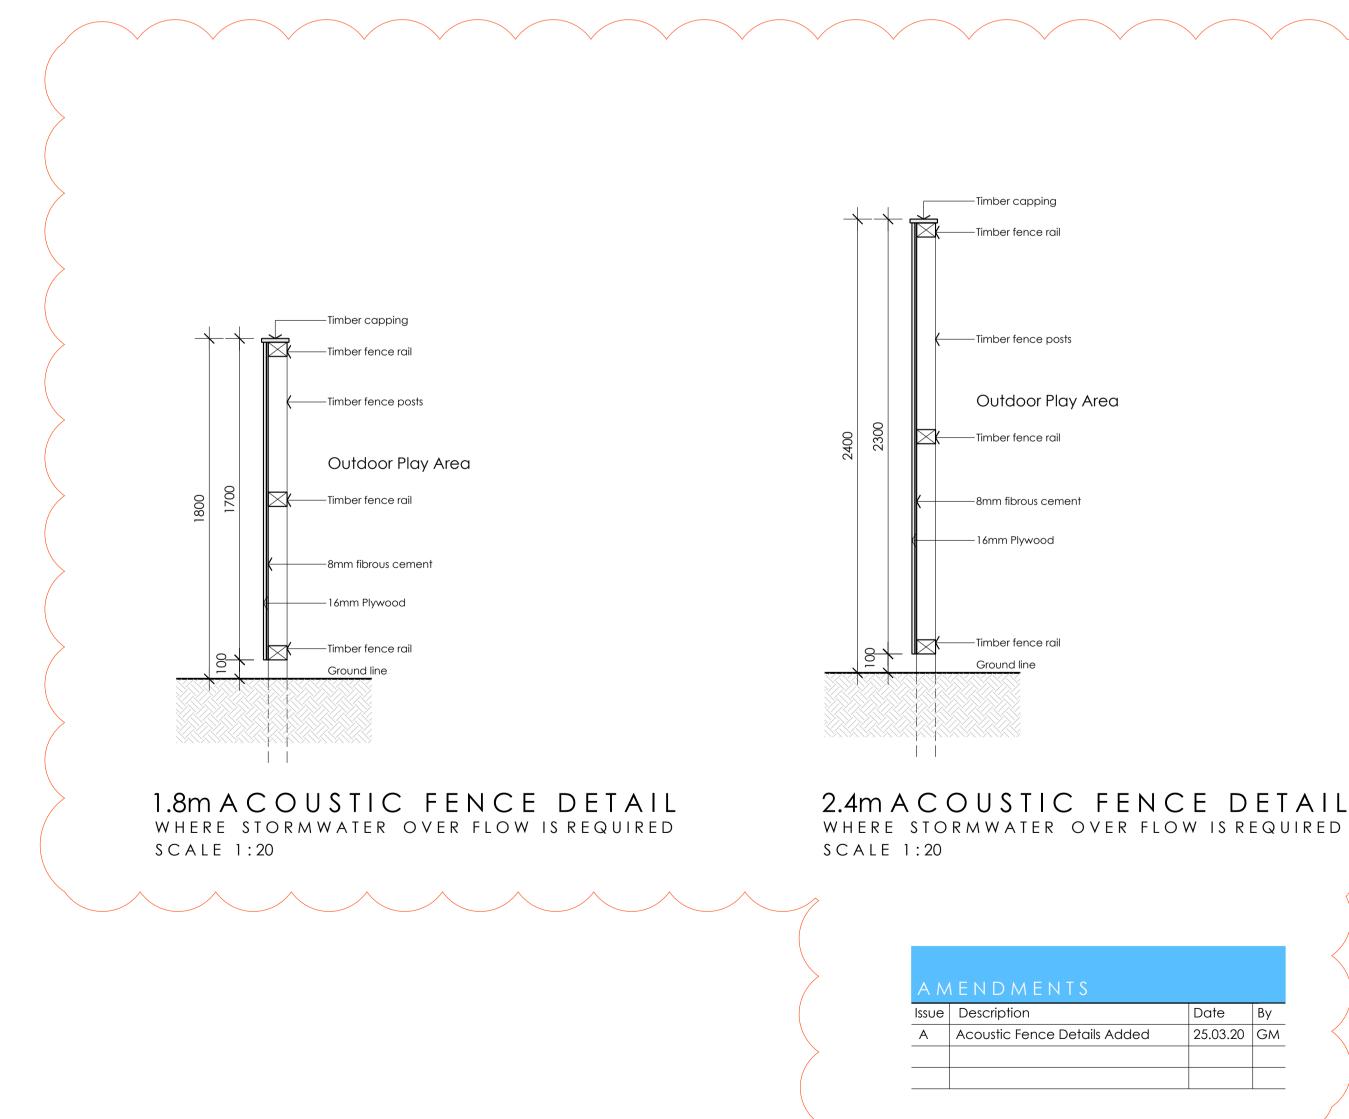

Vladimir Vanovac and Mark Toma

Proposed Childcare Centre

110 - 112 Mount Vernon Road Mount Vernon NSW

Notes and Acoustic Fence

Checked: GM

Scale: As Shown

Job No. 18307

Drawn: GM

North Point

Date: 20.04.2020



Project Works Design Pty Ltd ABN 97 108 707 482 a. p.o. box 5138 chittaway bay nsw 2261 p. 0412 637 875 admin@pwdesign.com.au

www.pwdesign.com.au

©Copyright This drawing is Copyright and is the property of Project Works Design Pty Limited. It must not be copied or reproduced in any way without the written permission of Project Works Design Pty Limited

Rev Date Description



3D View Aerial View From Mount Vernon Road Artistic Impression Only



Title: 3D View - Sheet 1 DA08 Checked: GM Job No. 18307



3D View Outdoor Play Area Artistic Impression Only



Project Works Design Pty Ltd ABN 97 108 707 482 a. p.o. box 5138 chittaway bay nsw 2261 p. 0412 637 875 admin@pwdesign.com.au

This drawing is Copyright and is the property of Project Works Design Pty Limited. It must not be copied or reproduced in any way without the written permission of Project www.pwdesign.com.au Works Design Pty Limited

Vladimir Vanovac and Mark Toma

Proposed Childcare Centre 110 - 112 Mount Vernon Road Mount Vernon NSW

3D View - Sheet 2 Checked: GM

Scale: N.T.S.

DA10 Job No. 18307

DA10



3D View From Mount Vernon Road Artistic Impression Only

PROJECT WORKS DESIGN

Project Works Design Pty Ltd ABN 97 108 707 482 a. p.o. box 5138 chittaway bay nsw 2261 p. 0412 637 875 admin@pwdesign.com.au www.pwdesign.com.au

©Copyright This drawing is Copyright and is the property of Project Works Design Pty Limited. It must not be copied or reproduced in any way without the written permission of Project Works Design Pty Limited

Vladimir Vanovac and Mark Toma Proposed Childcare Centre 110 - 112 Mount Vernon Road Mount Vernon NSW

3D View - Sheet 3 Checked: GM Job No. 18307 Scale: N.T.S.

DA11



3D View Streetscape View From Mount Vernon Road Artistic Impression Only

PROJECT WORKS DESIGN

Project Works Design Pty Ltd ABN 97 108 707 482 a. p.o. box 5138 chittaway bay nsw 2261 p. 0412 637 875 admin@pwdesign.com.au www.pwdesign.com.au

©Copyright This drawing is Copyright and is the property of Project Works Design Pty Limited. It must not be copied or reproduced in any way without the written permission of Project Works Design Pty Limited

Vladimir Vanovac and Mark Toma

Proposed Childcare Centre 110 - 112 Mount Vernon Road Mount Vernon NSW

3D View - Sheet 4 Checked: GM Job No. 18307 Scale: N.T.S.